

# CERTIFICATE OF LOCATION OF GOVERNMENT CORNER

County of Anoka

State of Minnesota


## East 1/4 Corner of Sec. 25 Township 33 Range 22

On the 20th day of January, 1971, the described corner was evidenced by a cast iron monument set by Don Hult

and to perpetuate the location of said corner, at the exact location thereof, a permanent marker was placed consisting of a "Chisago County" cast iron monument with a post on the East side

AND on the 13th day of June, 2022, said permanent marker was found Up 0.5'± and leaning slightly southwesterly. The ties were updated.

Updated reference ties are as shown below.

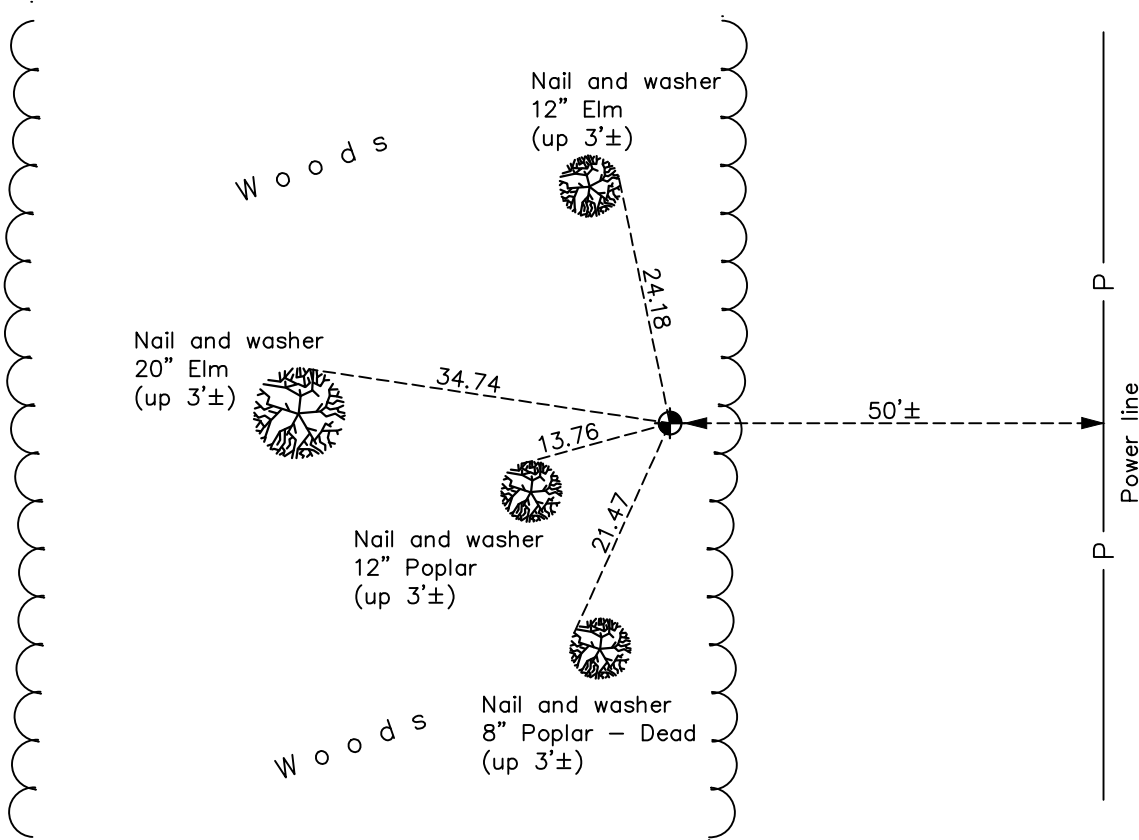

Revision Date  
 12/07/2022

N.A.D. 1983 Coordinates  
 (1996 Adjustment)

County Project Coordinates	
Northing	<u>203342.2972</u>
Easting	<u>563508.2744</u>
Date	<u>5/25/04</u>

I hereby certify that this United States public land survey monument record is correct and complete to the best of my knowledge and belief.  
David Zieglmeier Date 12/8/23  
 David Zieglmeier Anoka County Surveyor  
 Minnesota License Number 46179

# HISTORY OF GOVERNMENT CORNER

Page No. 113

County of Anoka

State of Minnesota

East 1/4 Corner of Sec. 25 Township 33 Range 22

## **CORNER HISTORY:**

January 20, 1971 - Set "Chisago County" cast iron monument up 0.2' and established ties to monument by Don C. Hult.

February 22, 1977 - Found cast iron monument set by Don Hult up 0.2'± and updated ties.

August 7, 1978 - Found cast iron monument and updated ties.

August 25, 1981 - Found cast iron monument and updated ties.

June 25, 1985 - Found cast iron monument and updated ties.

August 26, 1987 - Found cast iron monument and updated ties.

May 25, 2004 - Established NAD 1983 (1996 adj.) Anoka County project coordinates by static GPS methods.

September 8, 2014 - Found "Chisago County" cast iron monument up 0.5'± and slightly leaning southwest. Updated ties.

May 2, 2019 - Found "Chisago County" cast iron monument up 0.5'± and slightly leaning southwest. Verified position by VRS GPS methods. Updated ties.

June 13, 2022 - Found "Chisago County" cast iron monument up 0.5'± and slightly leaning southwestly, verified position by VRS GPS method and updated ties.