

# CERTIFICATE OF LOCATION OF GOVERNMENT CORNER

County of Anoka

State of Minnesota


## West 1/4 Corner of Sec. 35 Township 33 Range 22

On the 28th day of October, 1971, the described corner was evidenced by a concrete monument

and to perpetuate the location of said corner, at the exact location thereof, a permanent marker was placed consisting of 2" x 6.5' square steel Telspar w/ 'County Surveyor' cap and punchmark Sign and post on the East side

AND on the 20th day of June, 2022, said permanent marker was found 2" square steel Telspar w/ 'County Surveyor' cap and punchmark Up 1.5'±. Updated ties.

Updated reference ties are as shown below.

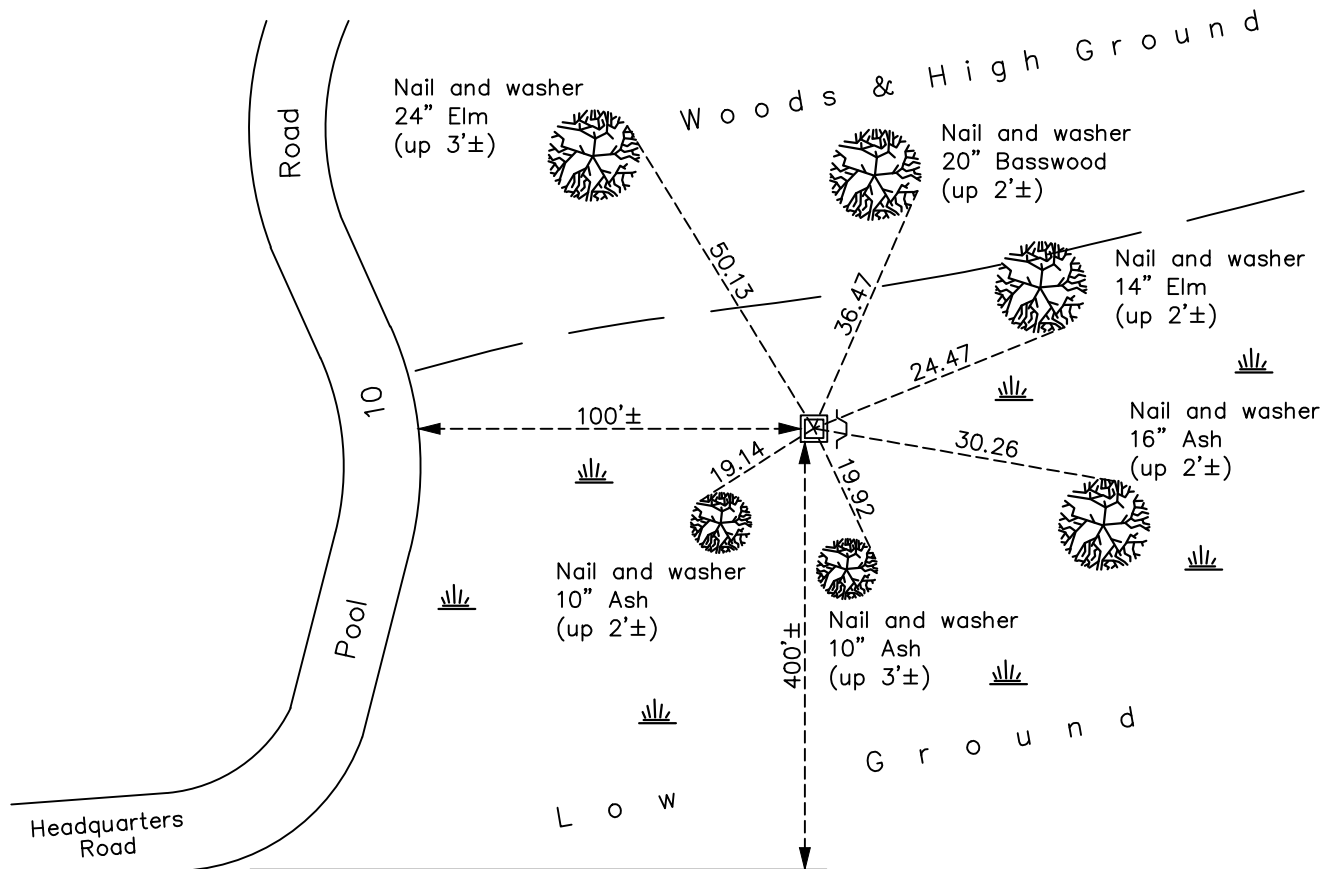

Revision Date  
 12/08/2022

N.A.D. 1983 Coordinates  
(1996 Adjustment)

County Project Coordinates	
Northing	<u>198133.6045</u>
Easting	<u>553022.0571</u>
Date	<u>5/04/05</u>

I hereby certify that this United States public land survey monument record is correct and complete to the best of my knowledge and belief.

*David Zieglmeier* Date 12/8/23

David Zieglmeier Anoka County Surveyor  
 Minnesota License Number 46179

# HISTORY OF GOVERNMENT CORNER

Page No. 136

County of Anoka

State of Minnesota

West 1/4 Corner of Sec. 35 Township 33 Range 22

## **CORNER HISTORY:**

October 28, 1971 - Found concrete monument up 1'± and updated ties.

July 30, 1975 - Found concrete monument and updated ties.

August 10, 1981 - Found concrete monument and updated ties.

October 17, 1990 - Found concrete monument and updated ties.

July 12, 2003 - Found concrete monument laying down on its side facing west. Monument straightened and the ties were updated.

May 4, 2005 - Established NAD 1983 (1996 adj.) Anoka County project coordinates by static GPS methods.

September 5, 2014 - Found concrete monument laying down and in need of reset.

October 15, 2014 - Set temporary spike and verified position by static GPS methods.

October 24, 2014 - Found temporary spike and replaced with a 2" x 6.5' square steel Telspar monument with punchmarked cap using static GPS methods. Verified position by VRS GPS methods and updated ties.

March 6, 2019 - Found 2" square steel Telespar monument w/punchmarked cap. Verified position by VRS GPS methods. Updated ties.

June 20, 2022 - Found 2" square steel Telespar monument w/punchmarked cap. Verified position by VRS GPS methods. Updated ties.