

CERTIFICATE OF LOCATION OF GOVERNMENT CORNER

County of Anoka

State of Minnesota


Northeast Corner of Sec. 1 Township 31 Range 24

On the 29th day of May, 1959, the described corner was evidenced by a granite monument

and to perpetuate the location of said corner, at the exact location thereof, a permanent marker was placed consisting of the same granite monument

AND on the 21st day of July, 2022, said permanent marker was found up 0.2'± with a sign and post on the north side and the ties were updated

Updated reference ties are as shown below.

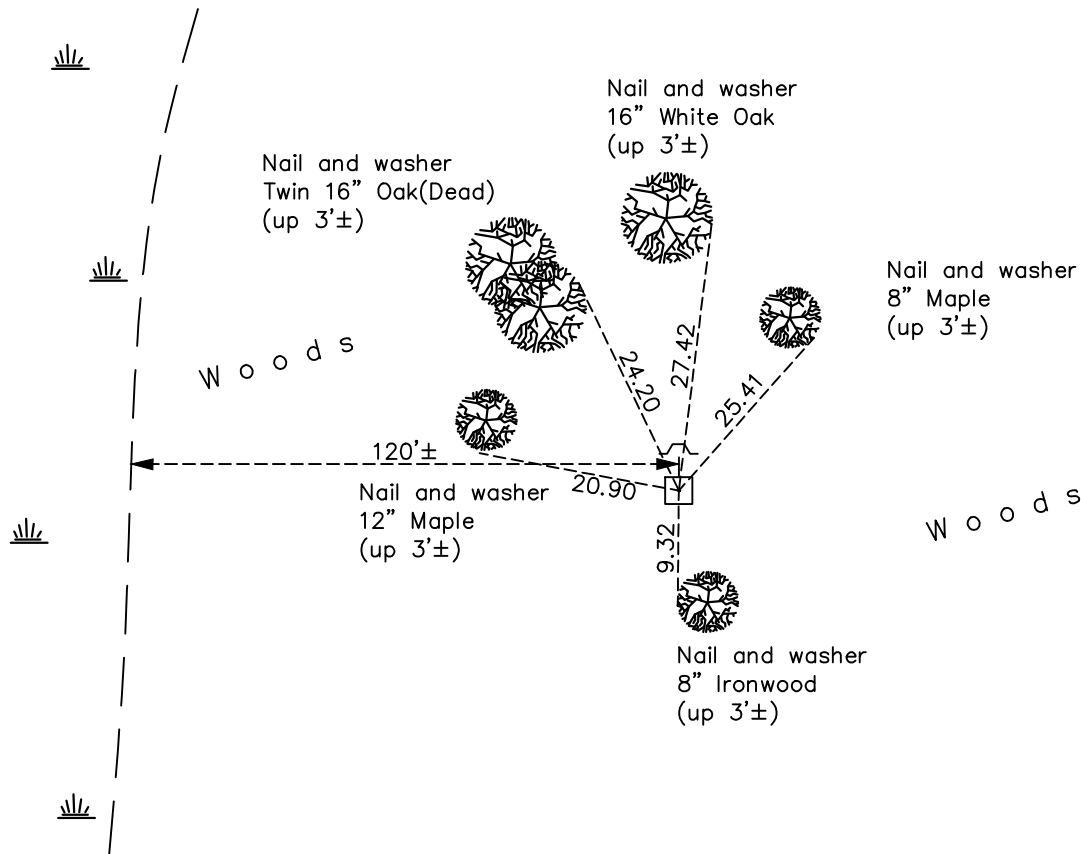

Revision Date
10/25/22

N.A.D. 1983 Coordinates
 (1996 Adjustment)

County Project Coordinates	
Northing	<u>164293.4322</u>
Easting	<u>500211.3207</u>
Date	<u>11/29/00</u>

I hereby certify that this United States public land survey monument record is correct and complete to the best of my knowledge and belief.
David Zieglmeier Date 2/8/23
 David Zieglmeier Anoka County Surveyor
 Minnesota License Number 46179

HISTORY OF GOVERNMENT CORNER

Page No. 1

County of Anoka

State of Minnesota

Northeast Corner of Sec. 1 Township 31 Range 24

CORNER HISTORY:

May 29, 1959 - Found granite monument. Established ties to monument.

June 8, 1964 - Found granite monument and updated ties.

July 11, 1966 - Found granite monument and updated ties.

July 22, 1970 - Found granite monument and updated ties.

July 1, 1974 - Found granite monument and updated ties.

June 27, 1977 - Found granite monument and updated ties.

November 8, 1983 - Found granite monument and updated ties.

June 20, 1986 - Found granite monument and updated ties.

August 25, 1994 - Found granite monument and updated ties.

February 4, 2000 - Found granite monument and updated ties.

November 29, 2000 - Found granite monument and established NAD 1983 (1996 Adjustment) Anoka County Project Coordinates by Static GPS methods. Updated ties.

March 11, 2010 - Found granite monument with a sign and post on the north side and updated ties.

March 20, 2015 - Found granite monument up 0.2'± with a sign and post on the north side and updated ties.

January 15, 2020 - Found granite monument up 0.2'± with a sign and post on the north side. Verified position by VRS GPS methods. Updated ties.

July 21, 2022 - Found granite monument up 0.2'± with a sign and post on the north side. Verified position by VRS GPS methods. Updated ties.