

CERTIFICATE OF LOCATION OF GOVERNMENT CORNER

County of Anoka

State of Minnesota


North $\frac{1}{4}$ Corner of Sec. 1 Township 31 Range 24

On the 23rd day of October, 1970, the described corner was evidenced by a concrete monument

and to perpetuate the location of said corner, at the exact location thereof, a permanent marker was placed consisting of a cast iron monument

AND on the 11th day of July, 2022, said permanent marker was found down 0.5± with a sign and post on the north side and the ties were updated

Updated reference ties are as shown below.

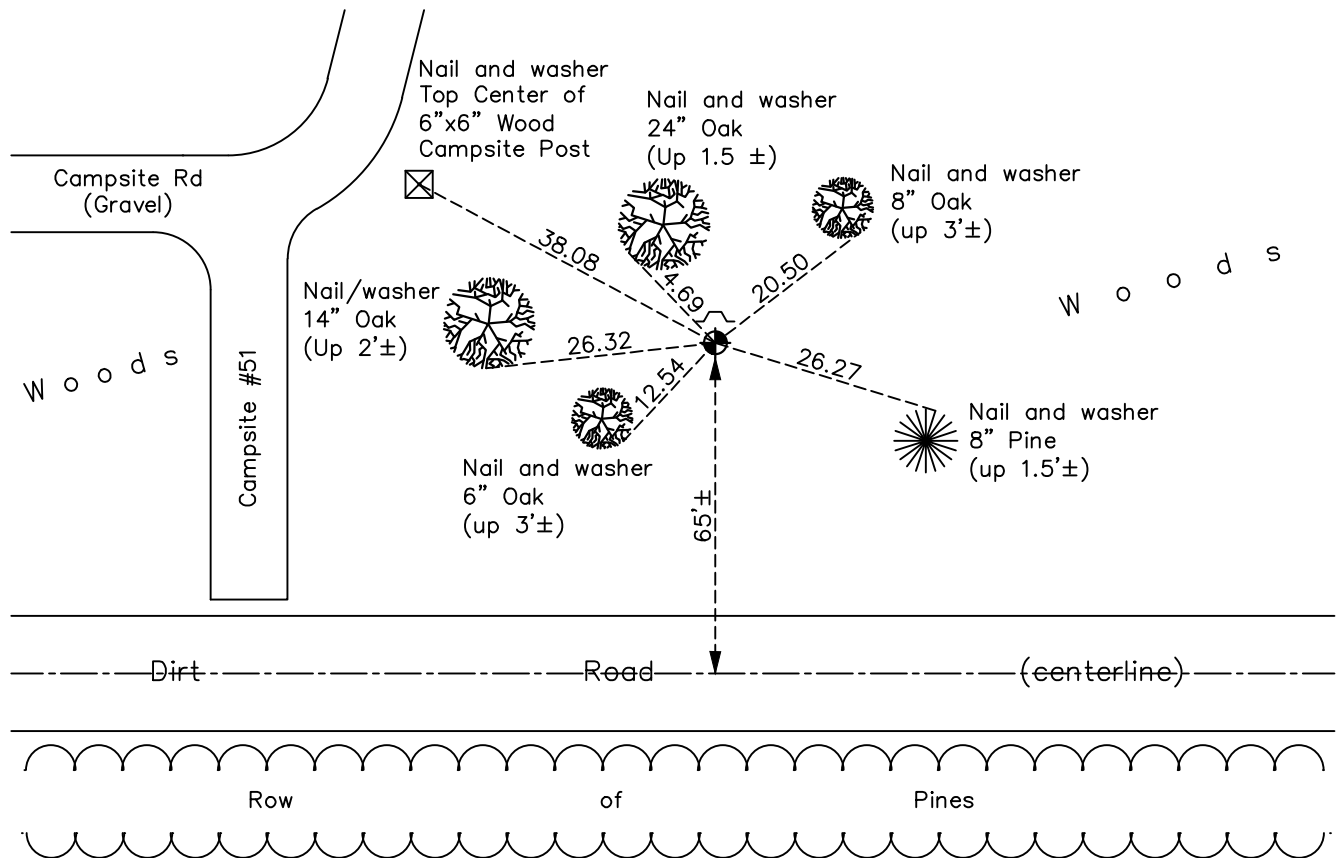

Revision Date
10/25/22

N.A.D. 1983 Coordinates
(1996 Adjustment)

| County Project Coordinates | |
|----------------------------|--------------------|
| Northing | <u>164315.1422</u> |
| Easting | <u>497595.8564</u> |
| Date | <u>11/27/00</u> |

I hereby certify that this United States public land survey monument record is correct and complete to the best of my knowledge and belief.

David Zieglmeier Date 2/8/23

David Zieglmeier Anoka County Surveyor
Minnesota License Number 46179

HISTORY OF GOVERNMENT CORNER

Page No. 2

County of Anoka

State of Minnesota

North 1/4 Corner of Sec. 1 Township 31 Range 24

CORNER HISTORY:

December 15, 1944 - H.A. Cartwright found concrete monument down 0.3'. Established ties to monument.

June 19, 1964 - Found concrete monument using ties by H.A. Cartwright dated December 15, 1944. Monument was found down 0.2' and 2.5' north of an east-west fence line. Set 1/2" iron pipe on north face of monument and updated ties.

July 11, 1966 - Found concrete monument and updated ties.

July 22, 1970 - Found concrete monument and updated ties.

October 23, 1970 - Replaced concrete monument with a cast iron monument and set sign and post 0.5' north of monument. Updated ties.

July 1, 1974 - Found cast iron monument and updated ties.

June 14, 1977 - Found cast iron monument and updated ties.

June 20, 1980 - Found cast iron monument and updated ties.

June 20, 1986 - Found cast iron monument and updated ties.

August 24, 1994 - Found cast iron monument and updated ties.

November 27, 2000 - Found cast iron monument and established NAD 1983 (1996 Adjustment) Anoka County Project Coordinates by Static GPS methods. Updated ties.

March 11, 2010 - Found cast iron monument down 0.2'± with sign and post on the north side and updated ties.

March 20, 2015 - Found cast iron monument with sign and post on the north side and updated ties.

January 8, 2020 - Found cast iron monument down 0.5'± with sign and post on the north side. Verified position by VRS GPS methods. Updated ties.

July 11, 2022 - Found cast iron monument down 0.5'± with sign and post on the north side. Verified position by VRS GPS methods. Updated ties.