

CERTIFICATE OF LOCATION OF GOVERNMENT CORNER

County of Anoka

State of Minnesota


West 1/4 Corner of Sec. 6 Township 31 Range 24

On the 19th day of July, 1979, the described corner was evidenced by area resurvey

and to perpetuate the location of said corner, at the exact location thereof, a permanent marker was placed consisting of a cast iron monument

AND on the 24th day of January, 2020, said permanent marker was found down 0.8'± with a sign and post 1'± North of monument facing South. The ties were updated

Updated reference ties are as shown below.

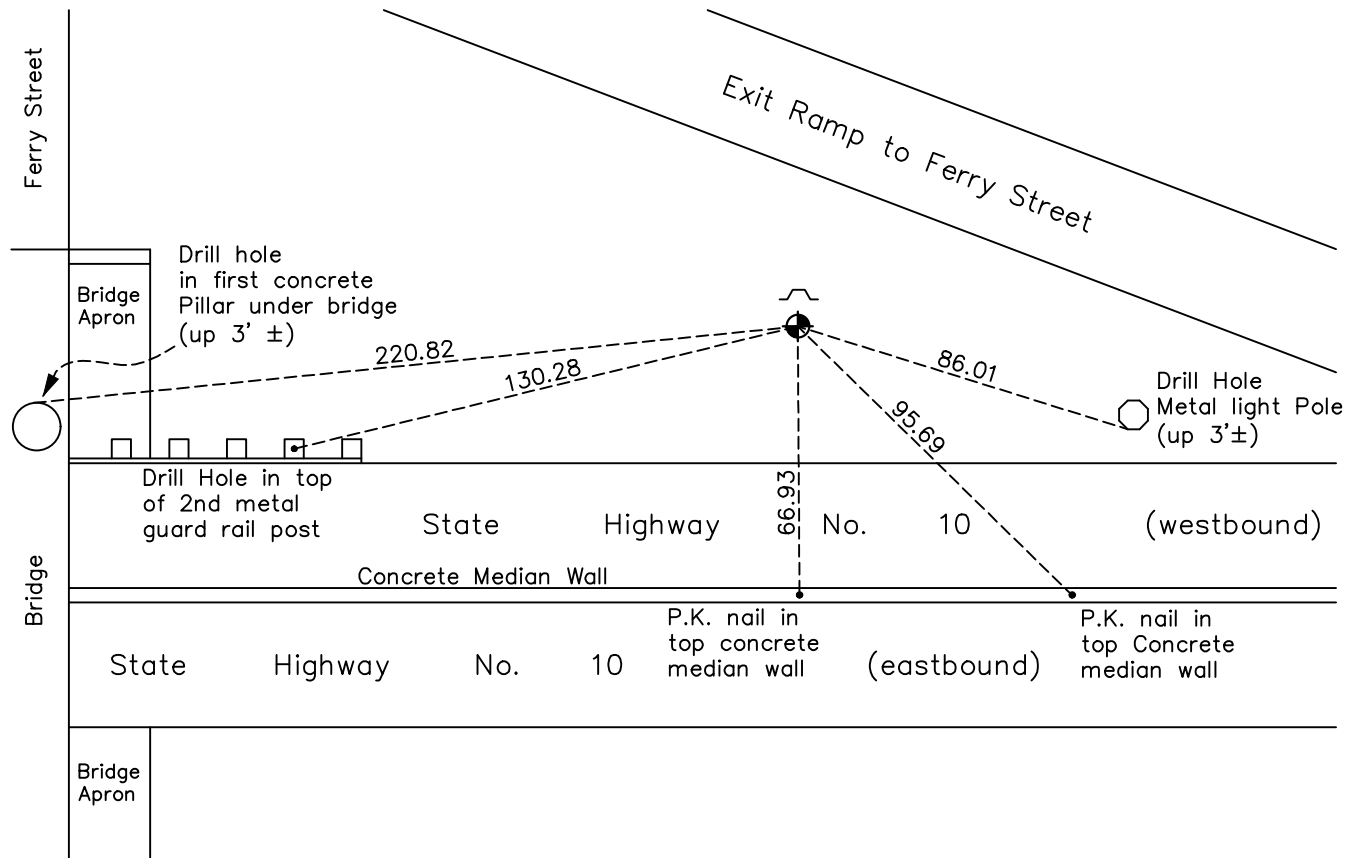

Revision Date
2/25/20

N.A.D. 1983 Coordinates
(1996 Adjustment)

County Project Coordinates	
Northing	161973.3851
Easting	468523.1177
Date	6/19/01

I hereby certify that this United States public land survey monument record is correct and complete to the best of my knowledge and belief.

David Zieglmeier Date 3/8/22

David Zieglmeier Anoka County Surveyor
Minnesota License Number 46179

HISTORY OF GOVERNMENT CORNER

Page No. 14

County of Anoka

State of Minnesota

West 1/4 Corner of Sec. 6 Township 31 Range 24

CORNER HISTORY:

September 28, 1959 - N.C. Hoium found an iron pipe. Established ties to monument.

August 11, 1960 - Found iron pipe and updated ties.

October 5, 1961 - Found 1/2" iron pipe and updated ties.

June 25, 1963 - Found 3/4" iron pipe and updated ties.

November 18, 1964 - Replaced 3/4" iron pipe with a cast iron monument with steel fence post. Updated ties.

September 1, 1965 - Set cast iron monument on slope and flush with surface after road construction using ties taken prior to construction.

July 27, 1966 - Found cast iron monument and updated ties.

June 15, 1977 - Found cast iron monument and updated ties.

July 19, 1979 - Found cast iron monument missing. Reset position of corner with cast iron monument set flush with surface using resurvey to east and west and with distances by Highway Department and N.C. Hoium.

July 10, 1980 - Found cast iron monument and updated ties.

November 9, 1983 - Found cast iron monument and updated ties.

June 23, 1986 - Found cast iron monument and updated ties.

May 30, 1991 - Found cast iron monument and updated ties.

June 19, 2001 - Found cast iron monument and established NAD 1983 (1996 Adjustment) Anoka County Project Coordinates by Static GPS methods.

March 25, 2010 - Found cast iron monument and updated ties.

April 13, 2015 - Found cast iron monument down 0.8'±. set sign & post 1'± North of monument. Verified position by VRS GPS methods. Updated ties.

January 24, 2020 - Found cast iron monument down 0.8'± with a sign & post 1'± North of monument. Verified position by VRS GPS methods. Updated ties.