

CERTIFICATE OF LOCATION OF GOVERNMENT CORNER

County of Anoka

State of Minnesota



West 1/4 Corner of Sec. 1 Township 31 Range 24

On the ____ day of November, 1968, the described corner was evidenced by a concrete monument

and to perpetuate the location of said corner, at the exact location thereof, a permanent marker was placed consisting of a cast iron monument

AND on the 4th day of August, 2022, said permanent marker was found down 0.1'± and the ties were updated

Updated reference ties are as shown below.

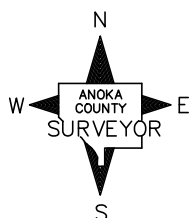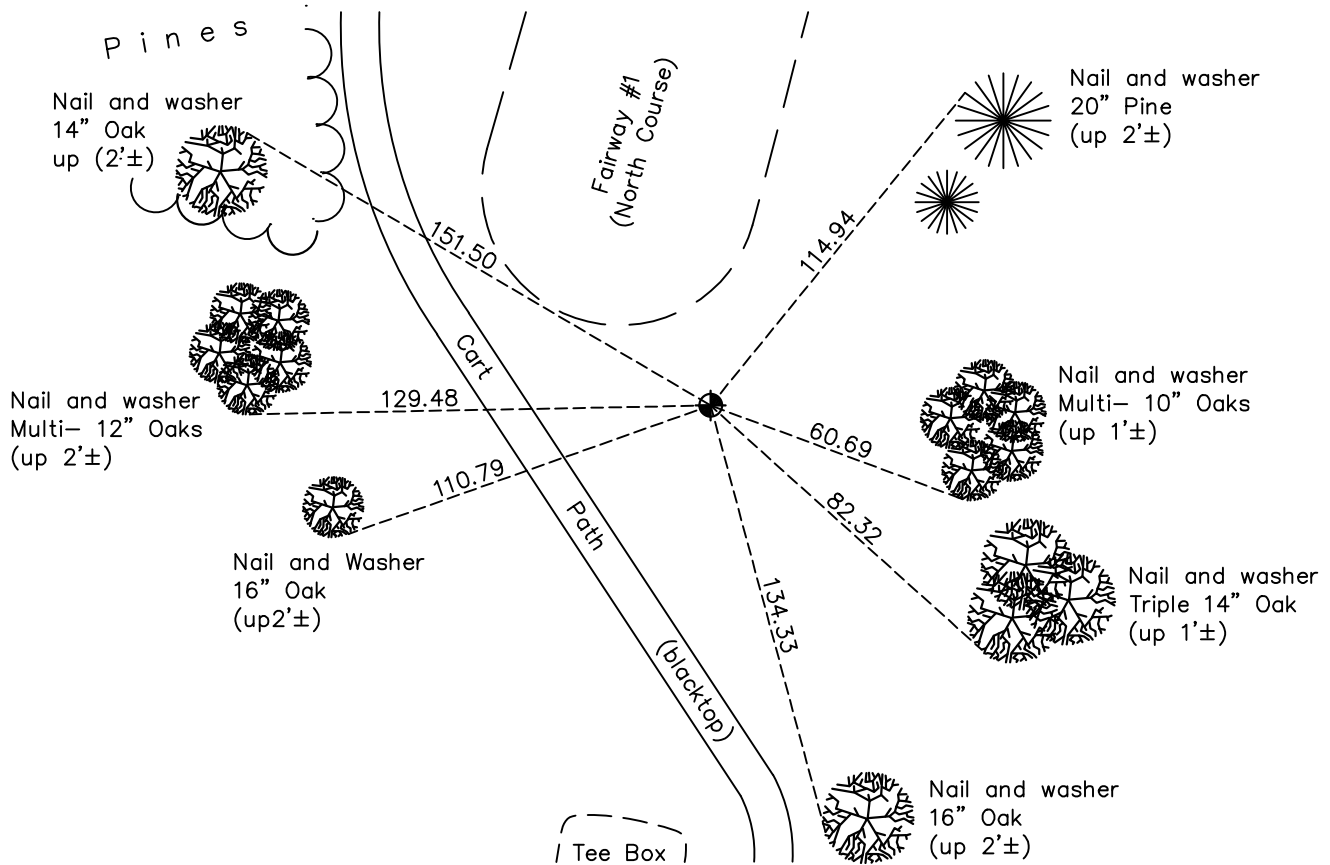

Revision Date
10/31/2022

N.A.D. 1983 Coordinates
(1996 Adjustment)

County Project Coordinates	
Northing	<u>161688.1668</u>
Easting	<u>494819.1987</u>
Date	<u>10/30/01</u>

I hereby certify that this United States public land survey monument record is correct and complete to the best of my knowledge and belief.

David Zieglmeier Date 2/8/23

David Zieglmeier Anoka County Surveyor
Minnesota License Number 46179

HISTORY OF GOVERNMENT CORNER

Page No. 21

County of Anoka

State of Minnesota

West 1/4 Corner of Sec. 1 Township 31 Range 24

CORNER HISTORY:

June 7, 1943 - H.A. Cartwright found concrete monument flush with surface. Established ties to monument.

August 3, 1960 - Found concrete monument flush with surface and updated ties.

June 8, 1964 - Found concrete monument with iron pipe on North side flush with surface and updated ties.

July 11, 1966 - Found concrete monument with iron pipe on North side flush with surface and updated ties.

October 13, 1966 - Found concrete monument and updated ties. Monument and all ties to be removed for construction of golf course by the City of Coon Rapids.

November 1968 - Set cast iron monument over remains of concrete monument flush with surface of golf course fairway and updated ties.

July 22, 1970 - Found cast iron monument in golf course fairway and updated ties.

July 2, 1974 - Found cast iron monument in golf course fairway and updated ties.

June 16, 1977 - Found cast iron monument in golf course fairway and updated ties.

June 27, 1980 - Found cast iron monument in golf course fairway and updated ties.

July 15, 1983 - Found cast iron monument in golf course fairway and updated ties.

June 17, 1986 - Found cast iron monument in golf course fairway and updated ties.

October 30, 2001 - Found cast iron monument in golf course fairway and established NAD 1983 (1996 Adjustment) Anoka County Project Coordinates by Static GPS methods. Updated ties.

March 23, 2010 - Found cast iron monument down 0.1'± in golf course fairway and updated ties.

May 29, 2015 - Found cast iron monument down 0.1'±. Verified position by VRS GPS methods. Updated ties.

January 22, 2020 - Found cast iron monument down 0.1'±. Verified position by VRS GPS methods. Updated ties.

August 4, 2022 - Found cast iron monument down 0.1'±. Verified position by VRS GPS methods. Updated ties.