

# CERTIFICATE OF LOCATION OF GOVERNMENT CORNER

County of Anoka

State of Minnesota


## South $\frac{1}{4}$ Corner of Sec. 2 Township 31 Range 24

On the 24th day of August, 1960, the described corner was evidenced by a railroad spike

and to perpetuate the location of said corner, at the exact location thereof, a permanent marker was placed consisting of a cast iron monument

AND on the 29th day of July, 2022, said permanent marker was found flush with surface and the ties were updated

Updated reference ties are as shown below.

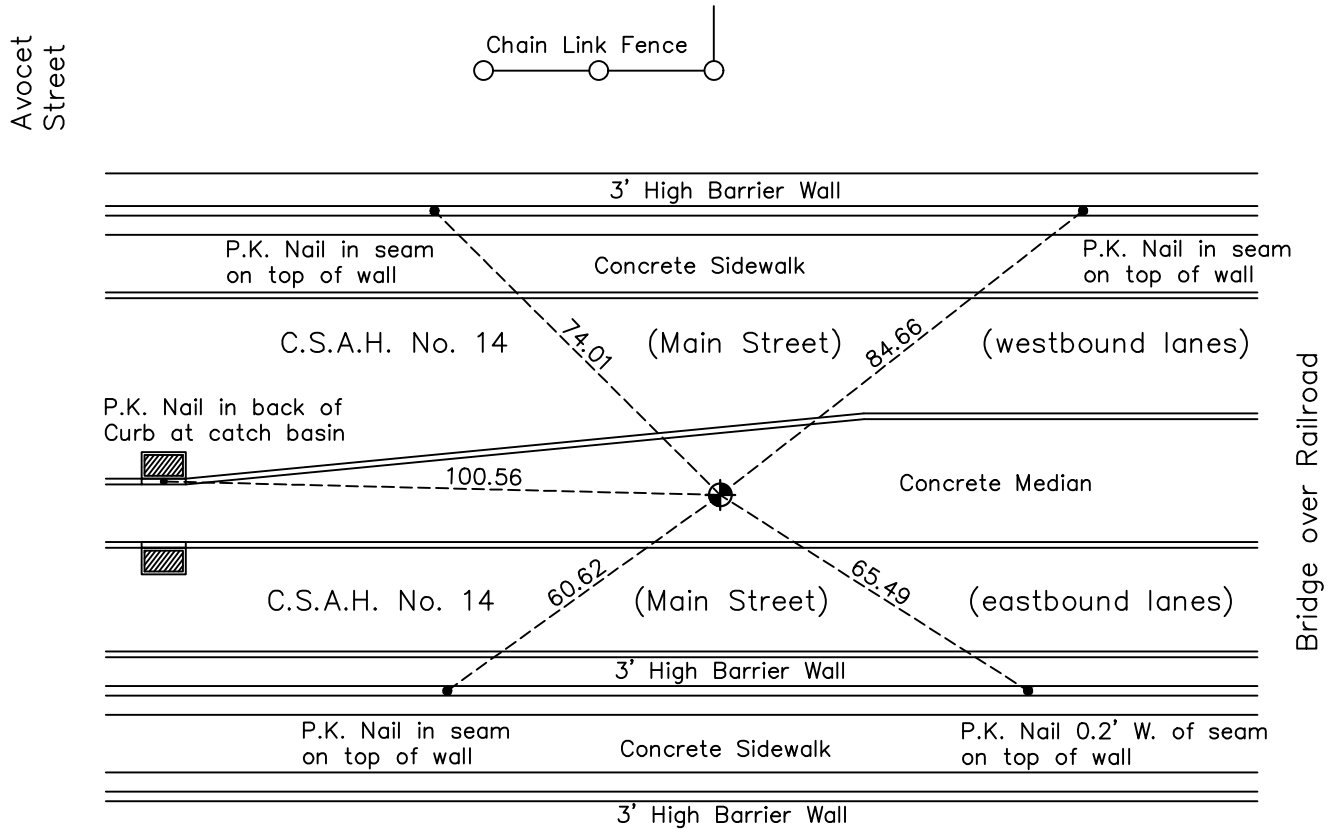

Revision Date  
10/31/2022

N.A.D. 1983 Coordinates  
 (1996 Adjustment)

County Project Coordinates	
Northing	<u>159013.2932</u>
Easting	<u>492284.3774</u>
Date	<u>9/27/01</u>

I hereby certify that this United States public land survey monument record is correct and complete to the best of my knowledge and belief.

*David Zieglmeier* Date 2/8/23

David Zieglmeier Anoka County Surveyor  
 Minnesota License Number 46179

# HISTORY OF GOVERNMENT CORNER

Page No. 30

County of Anoka

State of Minnesota

## South 1/4 Corner of Sec. 2 Township 31 Range 24

### **CORNER HISTORY:**

August 24, 1960 - Found railroad spike down 4'. Set cast iron monument flush. Established ties to monument.

June 29, 1964 - Found cast iron monument and updated ties.

July 18, 1966 - Found cast iron monument and updated ties.

July 22, 1970 - Found cast iron monument, set P.K. nails 2.00' North and East, raised monument 3 1/2" and updated ties.

July 4, 1974 - Found cast iron monument and updated ties.

June 20, 1977 - Found cast iron monument and updated ties.

June 24, 1980 - Found cast iron monument down. Raised flush and updated ties.

December 15, 1983 - Found cast iron monument and updated ties.

June 24, 1986 - Found cast iron monument and updated ties.

August 9, 1994 - Found cast iron monument and updated ties.

September 27, 2001 - Found cast iron monument and established NAD 1983 (1996 Adjustment) Anoka County Project Coordinates by Static GPS methods. Updated ties.

March 31, 2010 - Found cast iron monument down 0.3' and under the south centerline stripe and updated ties.

June 21, 2011 - Updated ties, verified location with VRS and removed cast iron monument prior to road construction.

August 22, 2012 - Set cast iron monument flush after road construction using ties. Verified location of corner by Static GPS methods.

April 14, 2015 - Found cast iron monument flush. Verified position by VRS GPS methods. Updated ties.

January 22, 2020 - Found cast iron monument flush. Verified position by VRS GPS methods. Updated ties.

July 29, 2022 - Found cast iron monument flush. Verified position by VRS GPS methods. Updated ties.