

# CERTIFICATE OF LOCATION OF GOVERNMENT CORNER

County of Anoka

State of Minnesota



## Southwest Corner of Sec. 2 Township 31 Range 24

On the 22nd day of August, 1960, the described corner was evidenced by a cast iron monument

and to perpetuate the location of said corner, at the exact location thereof, a permanent marker was placed consisting of a cast iron monument

AND on the 5th day of June, 2023, said permanent marker was found flush and the ties were updated (using total station inverse method)

Updated reference ties are as shown below.

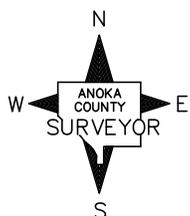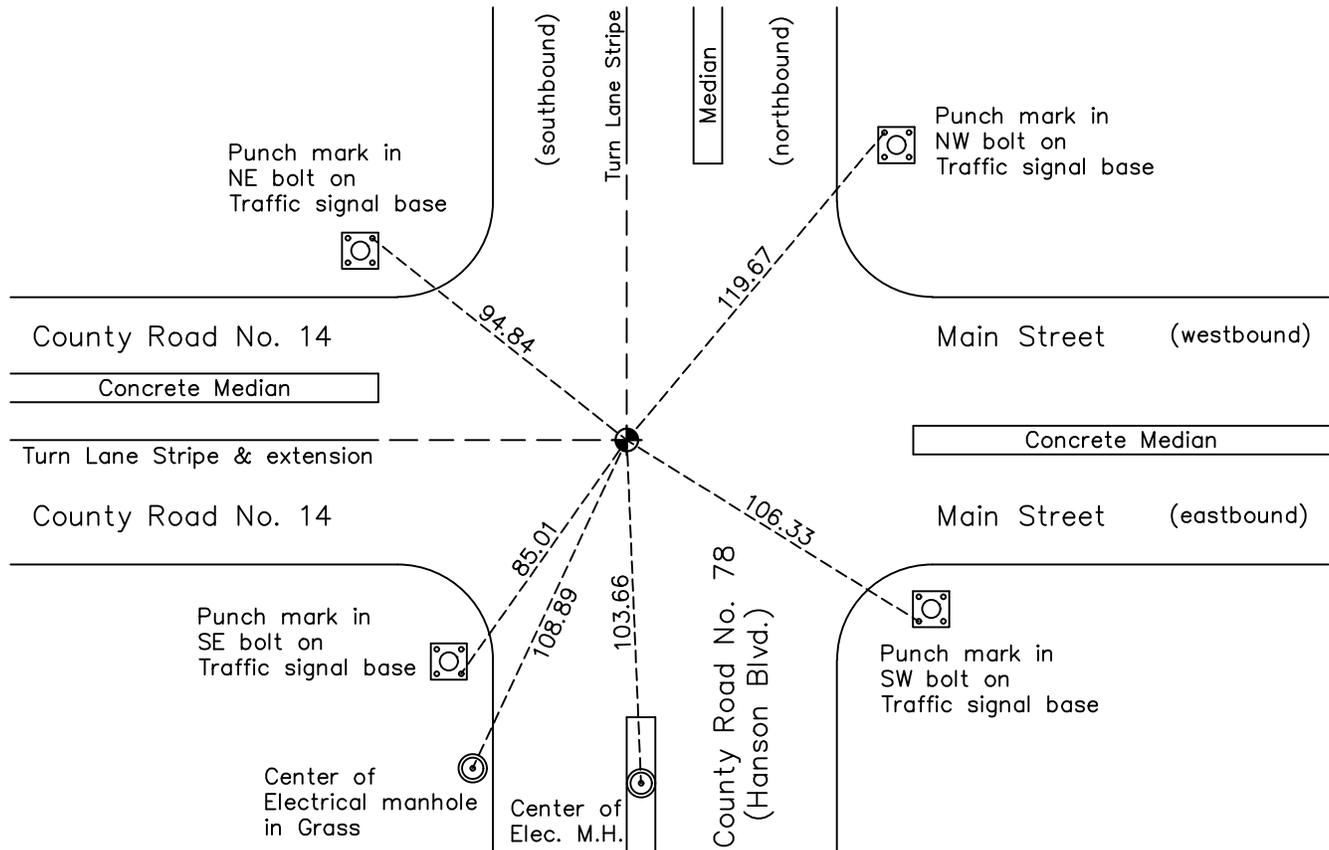

Revision Date  
6/20/2023

N.A.D. 1983 Coordinates  
(1996 Adjustment)

County Project Coordinates	
Northing	<u>159114.8237</u>
Easting	<u>489702.2096</u>
Date	<u>9/27/01</u>

I hereby certify that this United States public land survey monument record is correct and complete to the best of my knowledge and belief.

*David Zieglmeier* Date 6/28/23

David Zieglmeier Anoka County Surveyor  
Minnesota License Number 46179

# HISTORY OF GOVERNMENT CORNER

Page No. 31

County of Anoka

State of Minnesota

## Southwest Corner of Sec. 2 Township 31 Range 24

### **CORNER HISTORY:**

August 22, 1960 - Found cast iron monument flush with surface. Established ties to monument.

June 29, 1964 - Found cast iron monument and updated ties.

July 18, 1966 - Found cast iron monument and updated ties.

July 21, 1970 - Found cast iron monument and updated ties.

July 5, 1974 - Found cast iron monument and updated ties.

June 17, 1977 - Found cast iron monument and updated ties.

June 25, 1981 - Set construction ties (1/2" iron pipes on line to the North) and removed cast iron monument prior to road construction.

October 16, 1981 - Set P.K. nail after road construction using construction ties.

June 27, 1986 - Set cast iron monument after road construction using construction ties and area resurvey. Set P.K. nails 2.00' North and East and updated ties.

June 24, 1991 - Found cast iron monument and updated ties.

August 4, 1994 - Found cast iron monument and updated ties.

September 27, 2001 - Found cast iron monument and established NAD 1983 (1996 Adjustment) Anoka County Project Coordinates by Static GPS methods. Updated ties.

March 31, 2010 - Found cast iron monument down 0.3'± and updated ties.

July 22, 2011 - Found cast iron monument down 0.3'±. Raised flush with the new road surface.

April 29, 2015 - Found cast iron monument flush. Verified position by VRS GPS methods. Updated ties.

February 25, 2020 - Found cast iron monument flush. Verified position by VRS GPS methods. Updated ties.

June 5, 2023 - Found cast iron monument flush, verified position by ACS RTK GPS method and updated ties.