

CERTIFICATE OF LOCATION OF GOVERNMENT CORNER

County of Anoka

State of Minnesota


South 1/4 Corner of Sec. 5 Township 31 Range 24

On the 16th day of August, 1960, the described corner was evidenced by a granite monument

and to perpetuate the location of said corner, at the exact location thereof, a permanent marker was placed consisting of a cast iron monument

AND on the 5th day of June, 2023, said permanent marker was found flush and the ties were updated (using Total Station inverse method)

Updated reference ties are as shown below.

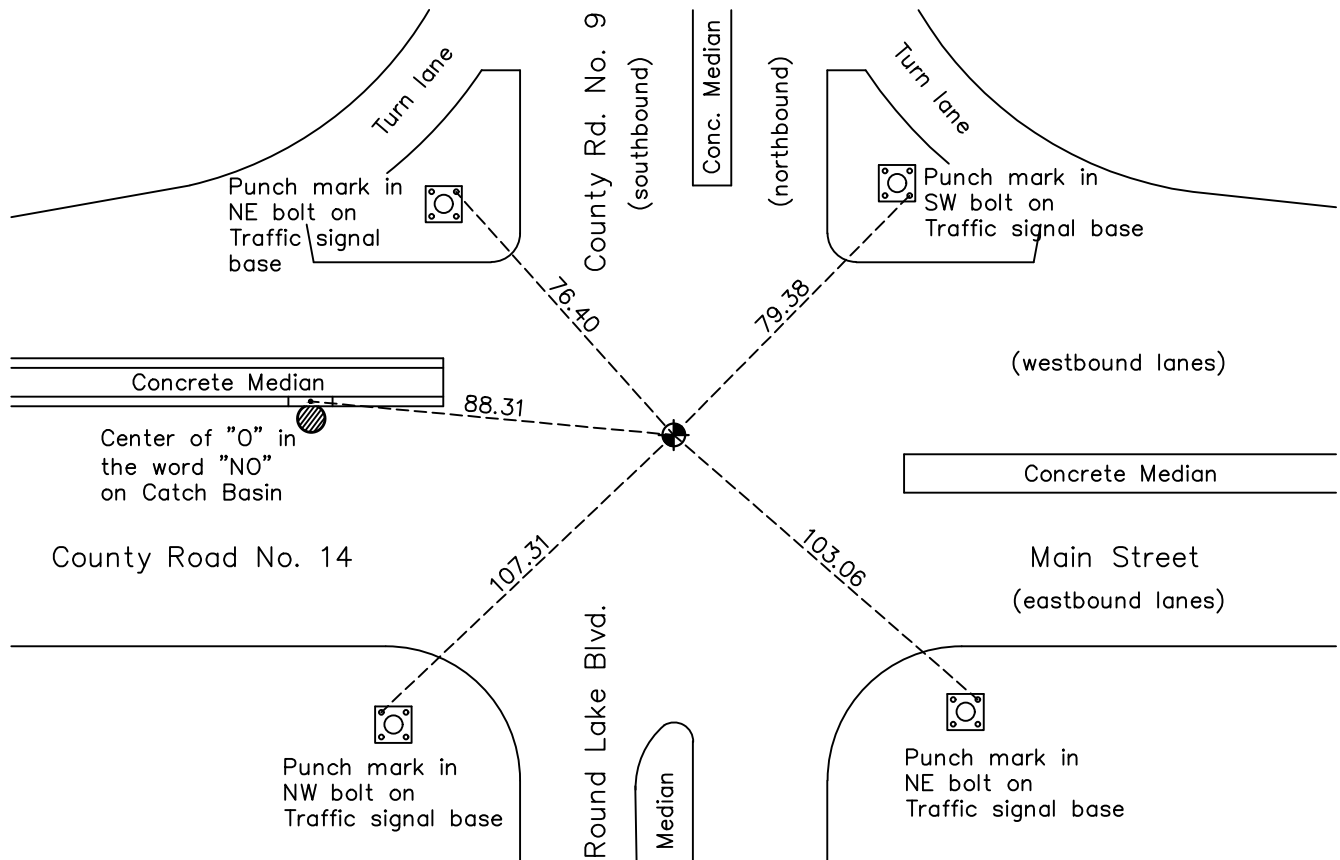

N.A.D. 1983 Coordinates
(1996 Adjustment)

County Project Coordinates	
Northing	<u>159169.8368</u>
Easting	<u>476440.0462</u>
Date	<u>9/28/01</u>

Revision Date
6/20/2023

I hereby certify that this United States public land survey monument record is correct and complete to the best of my knowledge and belief.

David Zieglmeier Date 6/28/23

David Zieglmeier Anoka County Surveyor
Minnesota License Number 46179

HISTORY OF GOVERNMENT CORNER

Page No. 36

County of Anoka

State of Minnesota

South 1/4 Corner of Sec. 5 Township 31 Range 24

CORNER HISTORY:

April 23, 1943 - H. A. Cartwright found granite monument down 10" with iron pipe on East side in centerline of Main Street. Established ties to monument.

August 9, 1955 - C.E. Coulter found granite monument down 3.5' in centerline of Main Street. Set iron pipe flush with surface and updated ties.

September 18, 1957 - Minnesota Highway Department found iron pipe down 0.1' in centerline of Main Street. Updated ties.

November 1959 - N.C. Hoium set iron pipe and updated ties.

August 16, 1960 - Found granite monument down 4'. Set cast iron monument on top of granite and flush with surface. Updated ties.

June 29, 1964 - Found cast iron monument and updated ties.

July 20, 1966 - Found cast iron monument and updated ties.

July 23, 1970 - Found cast iron monument and updated ties. Set P.K. nails 2.00' North and East.

July 19, 1974 - Found cast iron monument and updated ties.

June 17, 1977 - Found cast iron monument and updated ties.

June 26, 1980 - Found cast iron monument and updated ties.

July 25, 1983 - Found cast iron monument and updated ties.

June 24, 1986 - Found cast iron monument and updated ties.

August 7, 1990 - Set construction (transit) ties prior to road construction.

November 27, 1990 - Set cast iron monument flush after road construction using construction ties. Established temporary ties.

June 25, 1991 - Found cast iron monument and updated ties.

August 8, 1994 - Found cast iron monument and updated ties.

September 28, 2001 - Established NAD 1983 (1996 adj.) Anoka County project coordinates by static GPS methods.

March 25, 2010 - Found cast iron monument and updated ties.

April 29, 2015 - Found broken cast iron monument down 0.7'. Verified location with VRS GPS methods.

April 30, 2020 - Removed broken monument and replaced with a new cast iron monument. Updated ties

June 5, 2023 - Found cast iron monument flush, verified position by ACS RTK GPS method and updated ties.