

# CERTIFICATE OF LOCATION OF GOVERNMENT CORNER

County of Anoka

State of Minnesota


## Northwest Corner of Sec. 7 Township 31 Range 24

On the 2nd day of August, 1984, the described corner was evidenced by a P.K. Nail

and to perpetuate the location of said corner, at the exact location thereof, a permanent marker was placed consisting of a cast iron monument

AND on the 18th day of July, 2022, said permanent marker was found flush in the left turn lane and the ties were updated

Updated reference ties are as shown below.

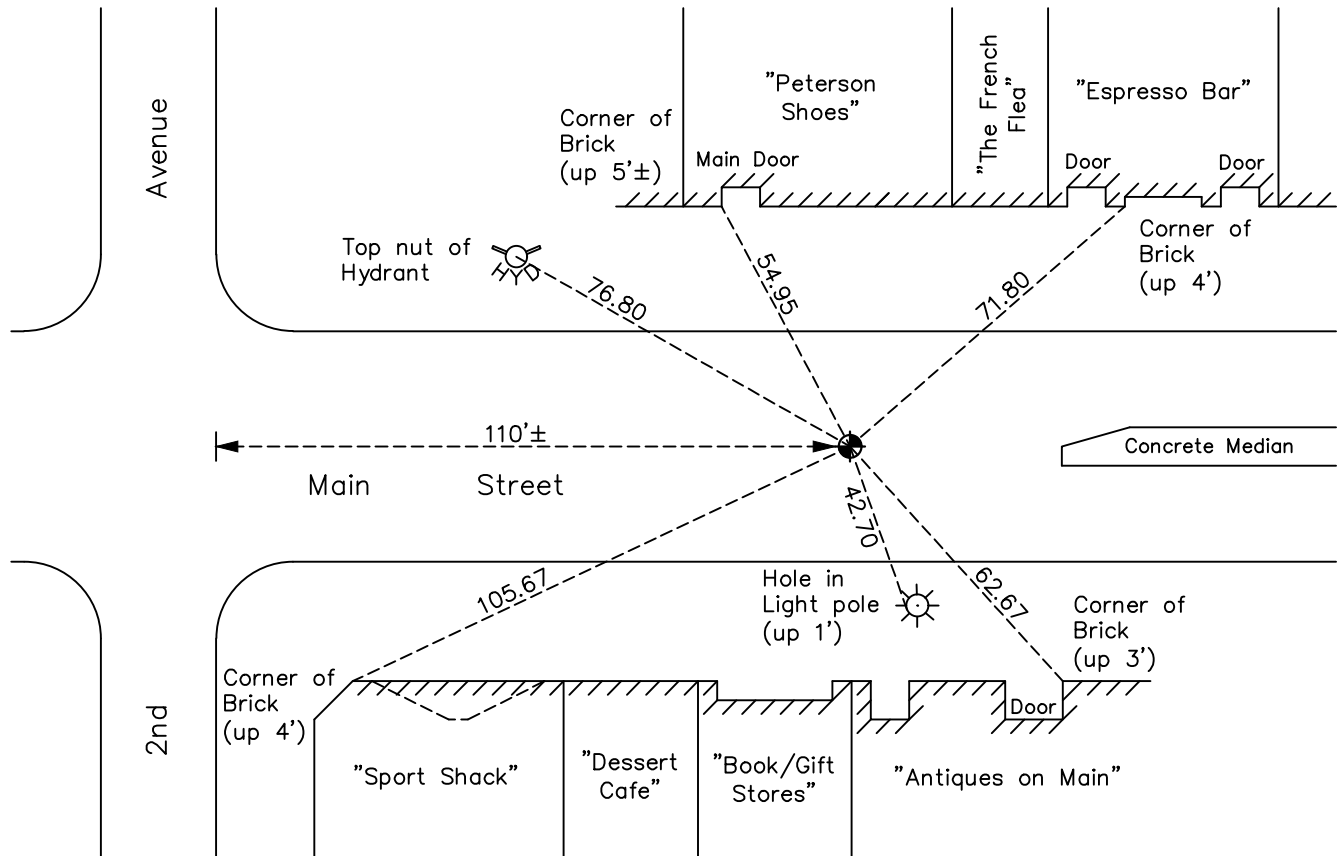

Revision Date  
12/08/2022

N.A.D. 1983 Coordinates  
 (1996 Adjustment)

County Project Coordinates	
Northing	<u>159333.2524</u>
Easting	<u>468496.5788</u>
Date	<u>6/19/01</u>

I hereby certify that this United States public land survey monument record is correct and complete to the best of my knowledge and belief.

*David Zieglmeier* Date 2/8/23

David Zieglmeier Anoka County Surveyor  
 Minnesota License Number 46179

# HISTORY OF GOVERNMENT CORNER

Page No. 38A

County of Anoka

State of Minnesota

## Northwest Corner of Sec. 7 Township 31 Range 24

### **CORNER HISTORY:**

January 8, 1981 - Set P.K. nail using area resurvey and established ties to monument.

July 26, 1983 - Found P.K. nail and updated ties.

August 2, 1984 - Replaced P.K. nail with a cast iron monument and set P.K. nails 2.00' north and east. Updated ties.

June 19, 1986 - Found cast iron monument and updated ties.

August 19, 1994 - Found cast iron monument and updated ties.

June 19, 2001 - Found cast iron monument and established NAD 1983 (1996 Adjustment) Anoka County Project Coordinates by Static GPS methods.

March 29, 2010 - Found cast iron monument and updated ties.

July 26, 2012 - Checked swing ties, verified location of corner by VRS GPS methods, set construction ties and removed cast iron monument prior to road construction.

November 16, 2012 - Set cast iron monument flush with surface after road construction using construction ties. Verified location of corner by VRS GPS methods.

May 4, 2015 - Found cast iron monument. Verified position by VRS GPS methods. Updated ties.

February 26, 2020 - Found cast iron monument. Verified position by VRS GPS methods. Updated ties.

July 18, 2022 - Found cast iron monument flush. Verified position by VRS GPS method. Updated ties.