

# CERTIFICATE OF LOCATION OF GOVERNMENT CORNER

County of Anoka

State of Minnesota


## East 1/4 Corner of Sec. 9 Township 31 Range 24

On the 10th day of July, 1969, the described corner was evidenced by area resurvey

and to perpetuate the location of said corner, at the exact location thereof, a permanent marker was placed consisting of red and white iron pipe (found laying down and removed on 11/19/2012)

AND on the 27th day of February, 2020, said permanent marker was not found

Updated reference ties are as shown below.

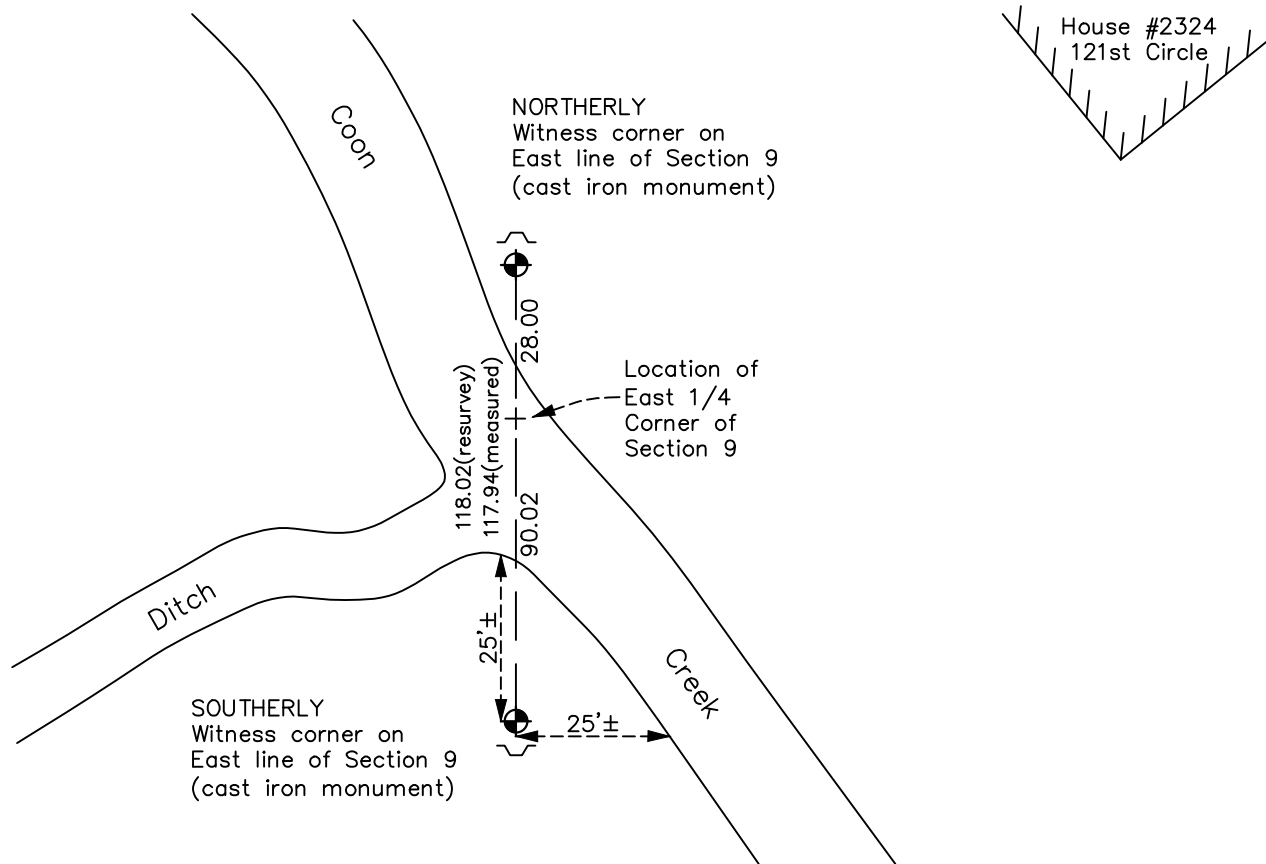

Revision Date  
5/6/2022

N.A.D. 1983 Coordinates  
 (1996 Adjustment)

County Project Coordinates	
Northing	<u>156,540.6959</u>
Easting	<u>484,325.8453</u>
Date	<u>Computed</u>

I hereby certify that this United States public land survey monument record is correct and complete to the best of my knowledge and belief.  
David Zieglmeier Date 2/6/24  
 David Zieglmeier Anoka County Surveyor  
 Minnesota License Number 46179

# HISTORY OF GOVERNMENT CORNER

Page No. 41

County of Anoka

State of Minnesota

East 1/4 Corner of Sec. 9 Township 31 Range 24

## **CORNER HISTORY:**

November 1847 - This corner was established by Issac N. Higbee, Deputy Surveyor. Higbee marked this position by "set quarter section post" with one bearing tree marked as an accessory.

July 10, 1969 - Set 1" iron pipe at East Quarter corner of Section 9 up 0.5'± and 2'± into Coon Creek using area resurvey. Established ties to monument.

July 29, 1970 - Set cast iron monuments for Witness corners using area resurvey and established ties to northerly monument.

September 17, 1974 - Set red and white iron pipe at East Quarter corner of Section 9 up 3'± in Coon Creek. Updated ties to northerly Witness corner.

June 20, 1977 - Set sign and post 1.0'± north of northerly Witness corner monument. Updated ties to northerly monument.

7/25/83, 6/18/86, 7/26/91, 8/22/94 - Found cast iron monuments and updated ties.

September 13, 2001 - Found cast iron monuments and established NAD 1983 (1996 Adjustment) Anoka County Project Coordinates by Static GPS methods on northerly monument. Updated ties.

March 29, 2010 - Found cast iron monuments and updated ties.

November 19, 2012 - Found 2" iron pipe laying down in creek and removed it. Found and verified location of both witness corner cast iron monuments by Static GPS methods.

November 28, 2012 - Reset both northerly and southerly witness corners to more accurately fit resurvey. Moved northerly witness corner north 0.03' and east 0.12' to fit previous Static GPS position. Moved southerly witness corner west 0.18' to a point on line between the calculated position of East 1/4 corner and Southeast corner of Section 9.

5/29/15, 2/27/20 - Found Northerly cast iron monument. Verified position by VRS GPS methods. Updated ties.