

CERTIFICATE OF LOCATION OF GOVERNMENT CORNER

County of Anoka

State of Minnesota


South $\frac{1}{4}$ Corner of Sec. 11 Township 31 Range 24

On the 23rd day of April, 2012, the described corner was evidenced by a concrete monument

and to perpetuate the location of said corner, at the exact location thereof, a permanent marker was placed consisting of cast iron monument

AND on the 9th day of February, 2023, said permanent marker was found down 0.2'± and the ties were updated.

Updated reference ties are as shown below.

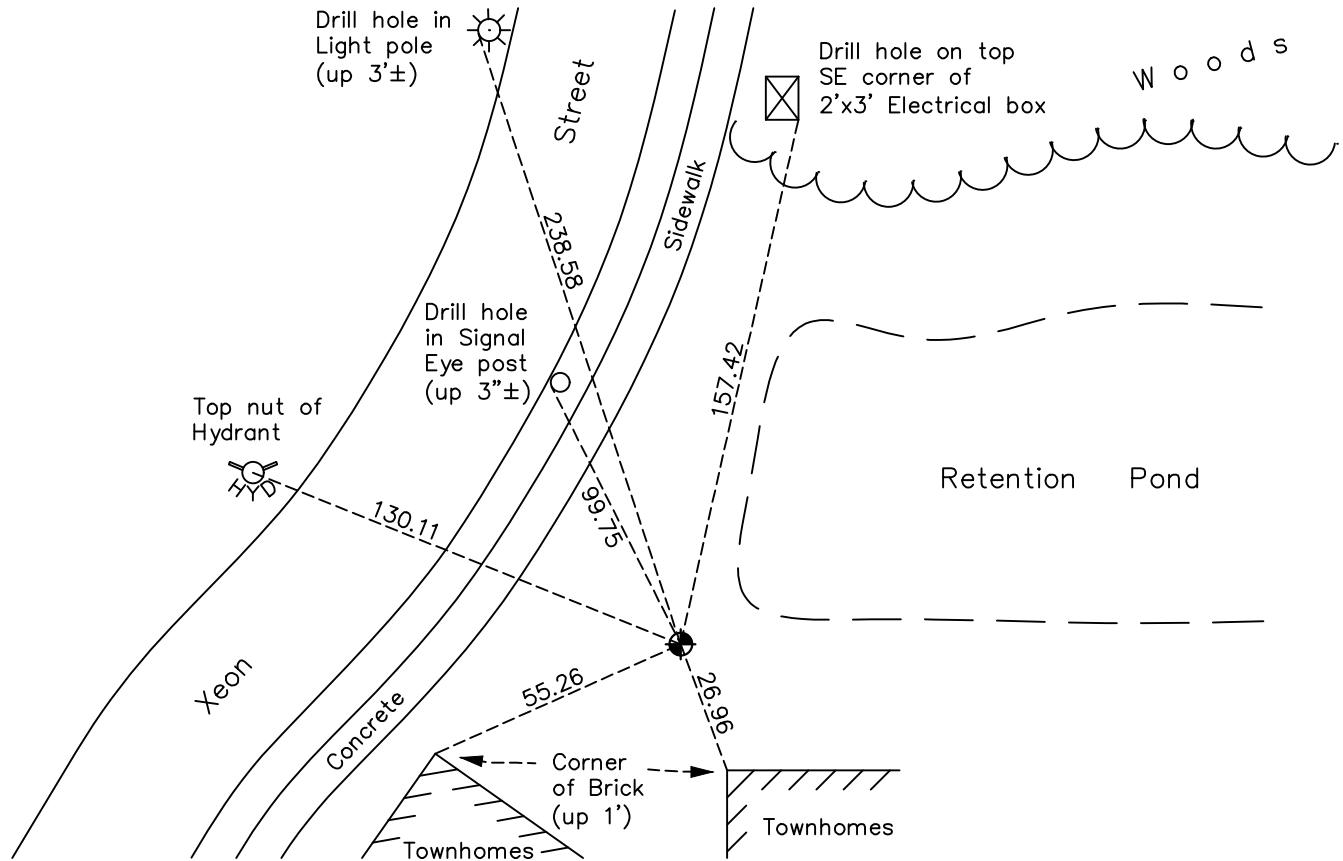

Revision Date
2/16/2023

N.A.D. 1983 Coordinates
(1996 Adjustment)

County Project Coordinates	
Northing	<u>153625.3884</u>
Easting	<u>492198.8074</u>
Date	<u>9/06/01</u>

I hereby certify that this United States public land survey monument record is correct and complete to the best of my knowledge and belief.

David Zieglmeier Date 2/28/23

David Zieglmeier Anoka County Surveyor
Minnesota License Number 46179

HISTORY OF GOVERNMENT CORNER

Page No. 49

HISTORY PG 1

County of Anoka

State of Minnesota

South 1/4 Corner of Sec. 11 Township 31 Range 24

CORNER HISTORY:

November 26, 1943 - H.A. Cartwright found concrete monument and established ties to monument.

July 22, 1960 - Found concrete monument up 1.5'± and updated ties.

June 5, 1964 - Found concrete monument and updated ties.

July 27, 1965 - Found concrete monument and updated ties.

July 18, 1966 - Found concrete monument and updated ties.

July 27, 1970 - Found concrete monument and updated ties.

July 8, 1974 - Found concrete monument and updated ties.

June 20, 1977 - Found concrete monument and updated ties.

October 23, 1978 - Found concrete monument leaning with ties gone. Straightened monument. Updated ties.

July 10, 1980 - Found concrete monument and updated ties.

June 19, 1986 - Found concrete monument and updated ties.

August 21, 1990 - Found concrete monument and set sign and post on the east side. Updated ties.

August 16, 1994 - Found concrete monument and updated ties.

September 6, 2001 - Found concrete monument and established NAD 1983 (1996 Adjustment) Anoka County Project Coordinates by Static GPS methods. Updated ties.

September 20, 2001 - Found concrete monument and updated ties.

September 29, 2005 - Found concrete monument and updated ties.

February 2010 - Found concrete monument missing. The position will be re-determined and a new monument set at a later date.

April 23, 2012 - Reset position of corner with a solid cast iron monument using construction ties (date set unknown) and GPS coordinates. Set corner half way in between tie position (0.13 north) and GPS position due to inability to determine the reason for difference. Verified position by Static GPS methods.

April 16, 2015 - Found cast iron monument and updated ties.

January 24, 2020 - Found cast iron monument broken off. Checked position of center fin by VRS GPS methods. Checked corner ties.

April 8, 2020 - Replaced broken monument with a cast iron monument set 0.2' below the surface.

July 22, 2022 - Found cast iron monument down 0.2'±, verified position by VRS GPS method and updated ties

HISTORY OF GOVERNMENT CORNER

Page No. 49

HISTORY PG 2

County of Anoka

State of Minnesota

South 1/4 Corner of Sec. 11 Township 31 Range 24

CORNER HISTORY:

February 9, 2023 - Found cast iron monument down 0.2'± , position coordinates were verified as correct by County RTK GPS method and the ties were updated.