

CERTIFICATE OF LOCATION OF GOVERNMENT CORNER

County of Anoka

State of Minnesota


North 1/4 Corner of Sec. 15 Township 31 Range 24

On the 19th day of July, 1960, the described corner was evidenced by a concrete monument

and to perpetuate the location of said corner, at the exact location thereof, a permanent marker was placed consisting of a cast iron monument

AND on the 23rd day of June, 2023, said permanent marker was found down 0.5'± and the ties were updated (using Trimble total station w/ mini prism)

Updated reference ties are as shown below.

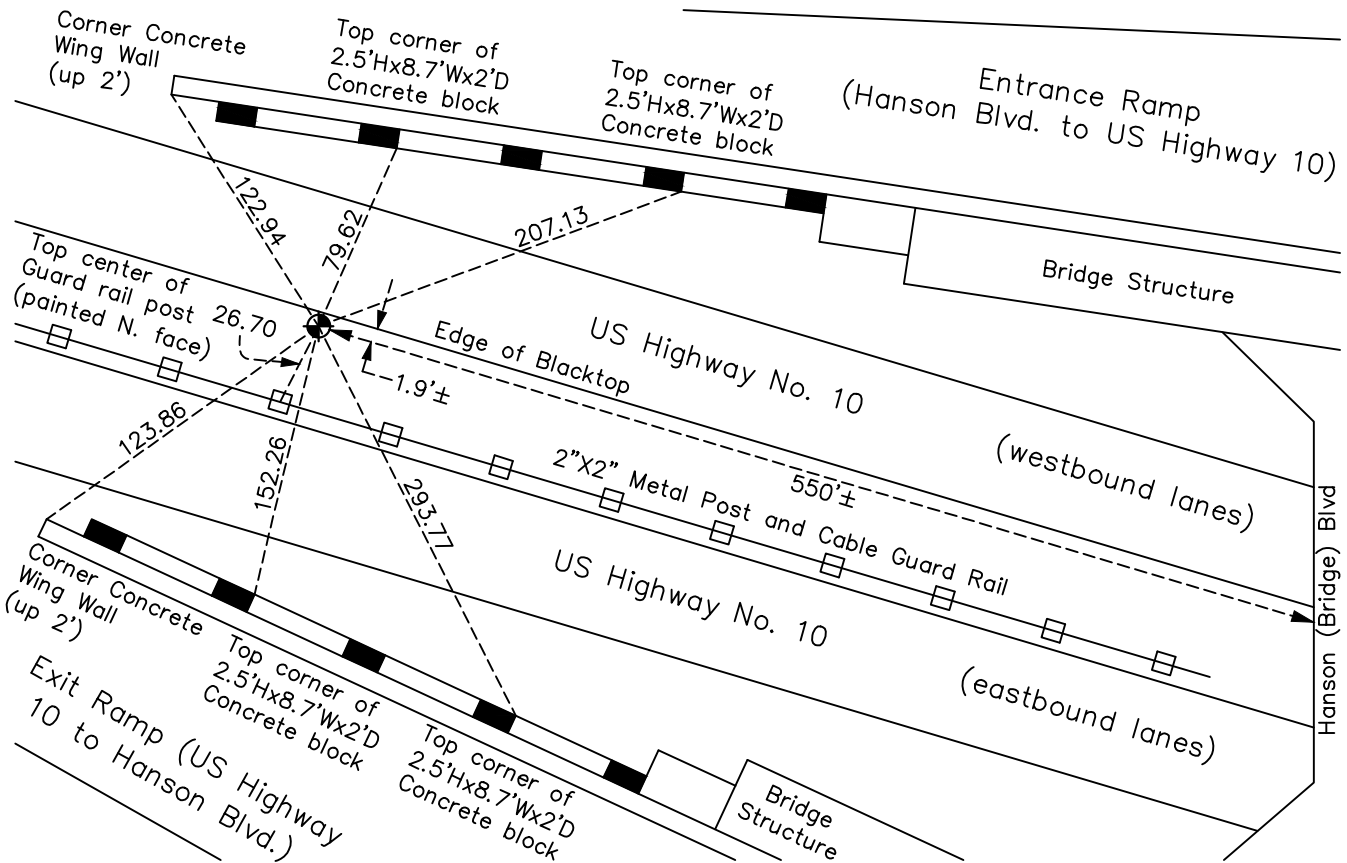

Revision Date
7/26/2023

N.A.D. 1983 Coordinates
(1996 Adjustment)

County Project Coordinates	
Northing	153811.7472
Easting	486918.4631
Date	9/19/01

I hereby certify that this United States public land survey monument record is correct and complete to the best of my knowledge and belief.

David Zieglmeier Date 12/11/23

David Zieglmeier Anoka County Surveyor
 Minnesota License Number 46179

HISTORY OF GOVERNMENT CORNER

Page No. 51

County of Anoka

State of Minnesota

North 1/4 Corner of Sec. 15 Township 31 Range 24

CORNER HISTORY:

November 10, 1944 - H.A. Cartwright found concrete monument set flush with the surface. Established ties to monument.

July 19, 1960 - Found concrete monument up 0.7'± with an iron pipe on the north side and updated ties.

April 27, 1965 - Set construction ties prior to road construction.

September 8, 1966 - Set bridge spike after road construction using construction ties.

October 19, 1966 - Replaced bridge spike with a cast iron monument and updated ties.

July 24, 1970 - Found cast iron monument and updated ties.

July 8, 1974 - Found cast iron monument and updated ties.

June 21, 1977 - Found cast iron monument and updated ties.

July 20, 1983 - Found cast iron monument and updated ties.

June 13, 1986 - Found cast iron monument and updated ties.

September 19, 2001 - Found cast iron monument and established NAD 1983 (1996 Adjustment) Anoka County Project Coordinates by Static GPS methods. Updated ties.

March 26, 2010 - Found cast iron monument down 0.3'± and updated ties.

April 27, 2015 - Found cast iron monument down 0.3'±. Verified position by VRS GPS methods. Updated ties.

February 27, 2020 - Found cast iron monument down 0.5'±. Verified position by VRS GPS methods. Updated ties.

June 23, 2023 - Found cast iron monument down 0.5'±. Verified position by RTK GPS method and updated ties.