

CERTIFICATE OF LOCATION OF GOVERNMENT CORNER

County of Anoka

State of Minnesota



West 1/4 Corner of Sec. 23 Township 31 Range 24

On the 24th day of September, 2001, the described corner was evidenced by red and white iron pipe

and to perpetuate the location of said corner, at the exact location thereof, a permanent marker was placed consisting of a red and white 2" square steel Telspar monument with a sign attached facing West found March 10, 2010

AND on the 27th day of July, 2022, said permanent marker was found up 2'± and the ties were updated

Updated reference ties are as shown below.

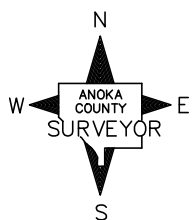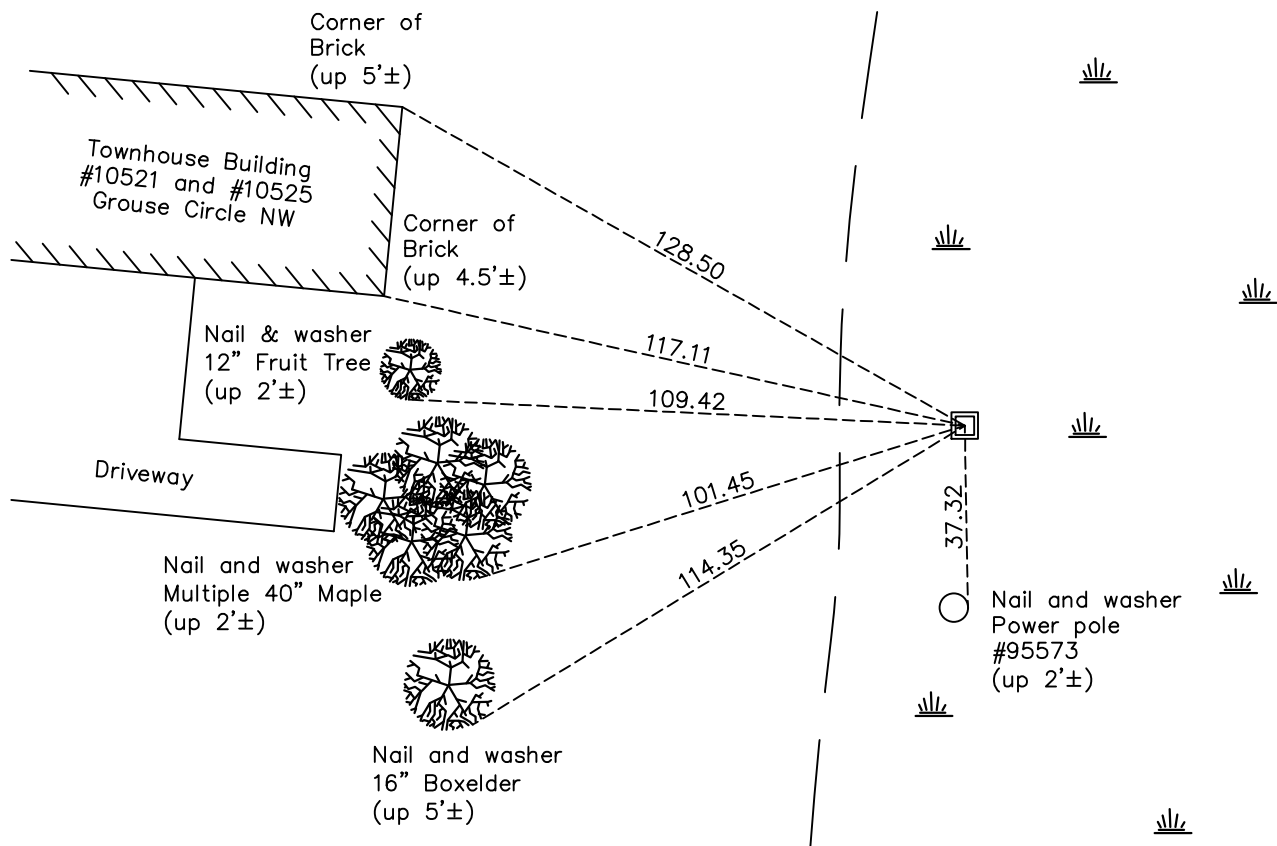

Revision Date
12/16/2022

N.A.D. 1983 Coordinates
 (1996 Adjustment)

County Project Coordinates	
Northing	<u>145809.4899</u>
Easting	<u>489434.5570</u>
Date	<u>9/24/01</u>

I hereby certify that this United States public land survey monument record is correct and complete to the best of my knowledge and belief.

David Zieglmeier Date 2/28/23

David Zieglmeier Anoka County Surveyor
 Minnesota License Number 46179

HISTORY OF GOVERNMENT CORNER

Page No. 75

County of Anoka

State of Minnesota

West 1/4 Corner of Sec. 23 Township 31 Range 24

CORNER HISTORY:

Summer 1957 - Minder Engineering Company found a 1-1/2" iron pipe set up 8". Established ties to monument.

December 14, 1960 - Found a 1-1/2" iron pipe set up 8"± and updated ties.

July 22, 1964 - Replaced 1-1/2" iron pipe with a 1" x 9' red and white iron pipe set up 3'. Updated ties.

July 21, 1966 - Replaced red and white iron pipe with a longer red and white iron pipe set up 3'. Updated ties.

August 3, 1970 - Found red and white iron pipe and updated ties.

July 9, 1974 - Found red and white iron pipe and updated ties.

August 1, 1974 - Found red and white iron pipe up 3'± and updated ties.

June 23, 1977 - Found red and white iron pipe and updated ties.

March 24, 1987 - Replaced bent red and white iron pipe with a new red and white iron pipe. Updated ties.

August 31, 1990 - Found red and white iron pipe and updated ties.

August 21, 1994 - Found red and white iron pipe and updated ties.

September 24, 2001 - Found red and white iron pipe and established NAD 1983 (1996 Adjustment) Anoka County Project Coordinates by Static GPS methods. Updated ties.

March 10, 2010 - Found a red and white 2" square steel Telspar monument (date set unknown) with a sign attached facing west. Updated ties.

May 26, 2015 - Found red and white 2" square steel Telspar monument up 2'±. Verified position by VRS GPS methods. Updated ties.

February 27, 2020 - Found red and white 2" square steel Telspar monument up 2'±. Verified position by VRS GPS methods. Updated ties.

July 27, 2022 - Found red and white 2" sq steel Telspar monument up 2'±, verified position by VRS GPS method and updated ties.