

CERTIFICATE OF LOCATION OF GOVERNMENT CORNER

County of Anoka

State of Minnesota


West 1/4 Corner of Sec. 26 Township 31 Range 24

On the 15th day of July, 1966, the described corner was evidenced by a 1/2" iron pipe set by Suburban Engineering

and to perpetuate the location of said corner, at the exact location thereof, a permanent marker was placed consisting of a cast iron monument

AND on the 7th day of July, 2022, said permanent marker was found down 1.2'± with a MNDOT sign and post on the north side, 15'± down the bank and the ties were updated

Updated reference ties are as shown below.

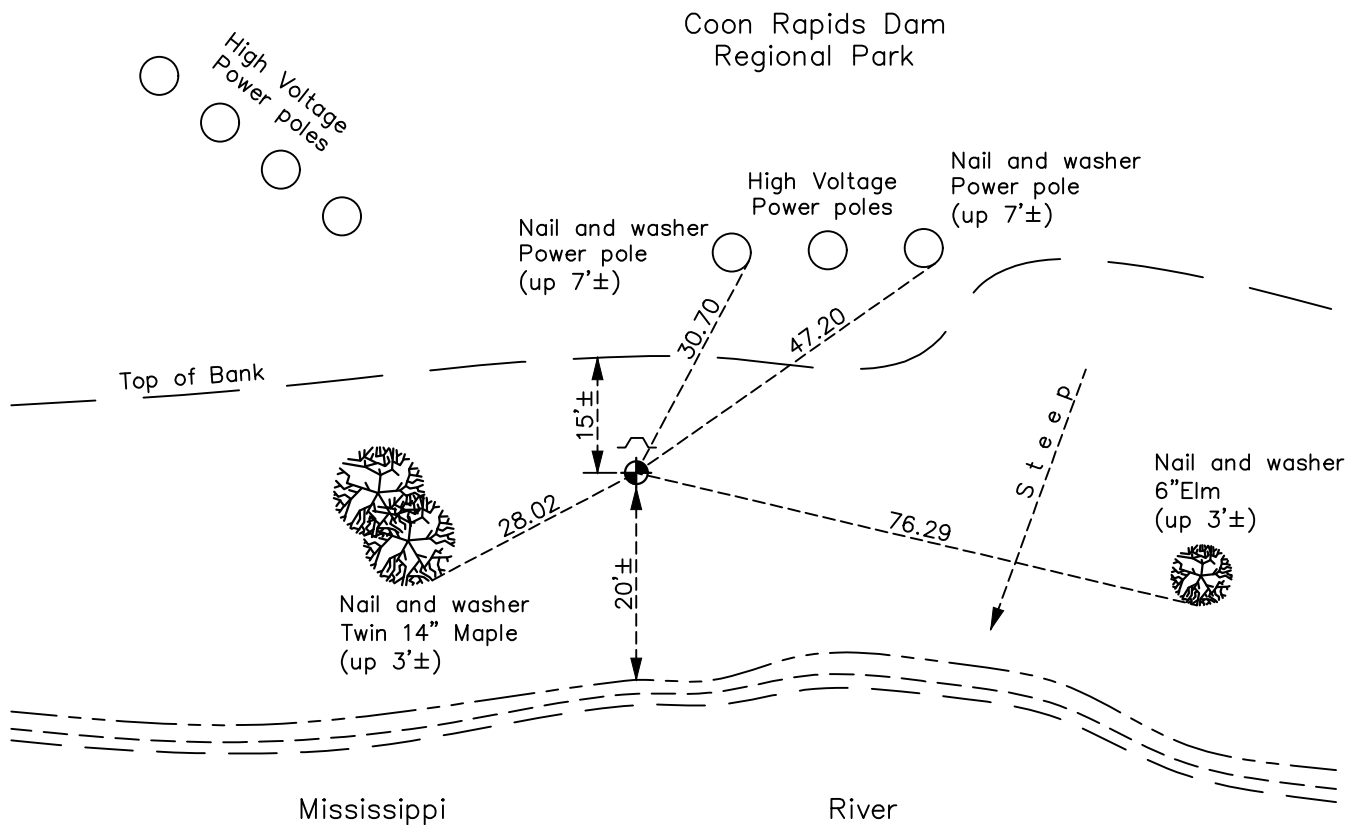

Revision Date
12/20/2022

N.A.D. 1983 Coordinates
(1996 Adjustment)

| County Project Coordinates | |
|----------------------------|-------------|
| Northing | 140413.3148 |
| Easting | 489342.1285 |
| Date | 10/10/01 |

I hereby certify that this United States public land survey monument record is correct and complete to the best of my knowledge and belief.
David Zieglmeier Date 2/28/23
David Zieglmeier Anoka County Surveyor
Minnesota License Number 46179

HISTORY OF GOVERNMENT CORNER

Page No. 86

County of Anoka

State of Minnesota

West 1/4 Corner of Sec. 26 Township 31 Range 24

CORNER HISTORY:

July 6, 1943 - H.A. Cartwright found concrete monument. Established ties to monument. The field notes for this monument label it as a Meander corner on the west line of the section.

April 17, 1964 - Found 1/2" iron pipe up 0.2' and believed to be set by Suburban Engineering using one tie to a 10" Willow. This iron pipe measures 136'± to a 24" Cottonwood, possibly Cartwright's 128.8' S 77° 24'E tie to a 12" Cottonwood. There was no evidence of additional Cartwright ties. Updated ties.

January 5, 1966 - Found 1/2" iron pipe and updated ties.

July 15, 1966 - Replaced 1/2" iron pipe with a cast iron monument set flush with the surface. Updated ties. There is a 2" iron pipe 4.7'± east of cast iron monument.

July 31, 1970 - Found cast iron monument and updated ties.

July 7, 1974 - Found cast iron monument and updated ties.

June 24, 1977 - Found cast iron monument and updated ties.

June 17, 1986 - Found cast iron monument and updated ties.

August 30, 1990 - Found cast iron monument and updated ties.

August 15, 1994 - Found cast iron monument and updated ties.

October 10, 2001 - Found cast iron monument and established NAD 1983 (1996 Adjustment) Anoka County Project Coordinates by Static GPS methods. Updated ties.

February 18, 2010 - Found cast iron monument down 1.2'± with sign and post on the north side of monument. Updated ties.

June 4, 2015 - Found cast iron monument down 1.2'± with a MnDOT sign and post on the north side. Monument is 15'± down from the top of bank. Verified position by VRS GPS methods. Updated ties.

March 10, 2020 - Found cast iron monument down 1.2'± with a MnDOT sign and post on the north side. Monument is 15'± down from the top of bank. Verified position by VRS GPS methods. Updated ties.

July 7, 2022 - Found cast iron monument down 1.2'± , verified position by VRS GPS Method and updated ties.