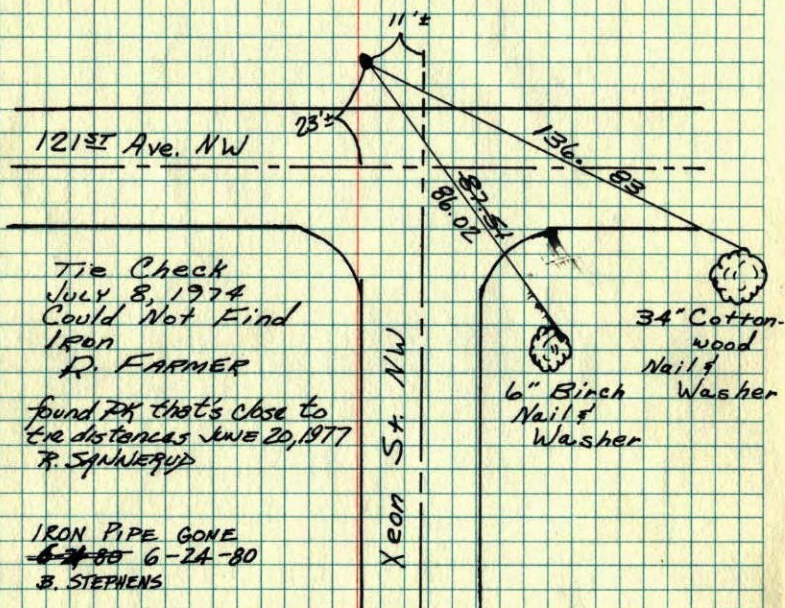


## Center Sec. 11-T31-R24


Found  $\frac{3}{4}$ " Pinched Iron Pipe Down 0.5'

August 29, 1968

D. Powell  
R. Olson  
P. Pieh

Dead file

## Center Sec. 11-T31-R24

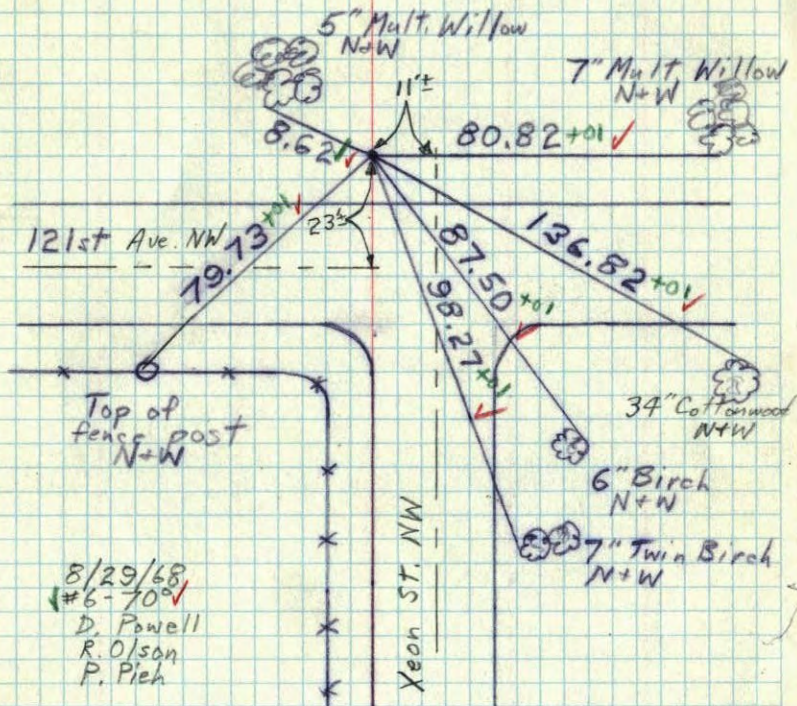Found  $\frac{3}{4}$ " Pinched Iron Pipe down 0.5'

MEMO from the desk of....

EDITH L. PATCH  
County Supt. of Schools


5/3/21/76  
Begin Mon. 10:00  
I have it here but  
country is very busy

Date \_\_\_\_\_

To \_\_\_\_\_

SUBJECT:

Center 11, T31, R24  
Slush?

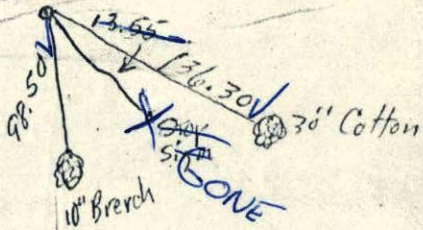

POUCHER  
PINKETTES

MEMO from the desk of....

EDITH L. PATCH  
County Supt. of Schools



5/3/21/76  
Begin Mon. 10:00  
I have it here but  
country is very busy

Date \_\_\_\_\_

To \_\_\_\_\_

SUBJECT:

Center 11, T31, R24  
Slush?

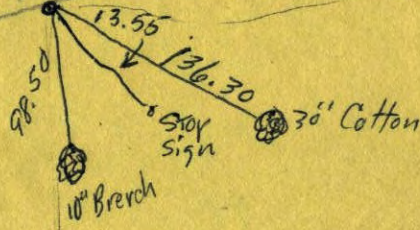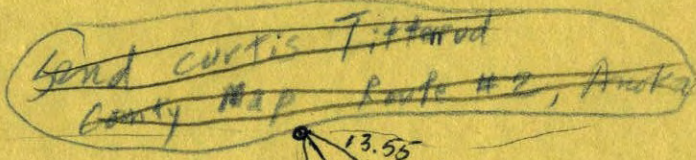

POUCHER  
PINKETTES