


Center of Sec. 36 T31 R24

1/2" Iron pipe to be removed by construction.

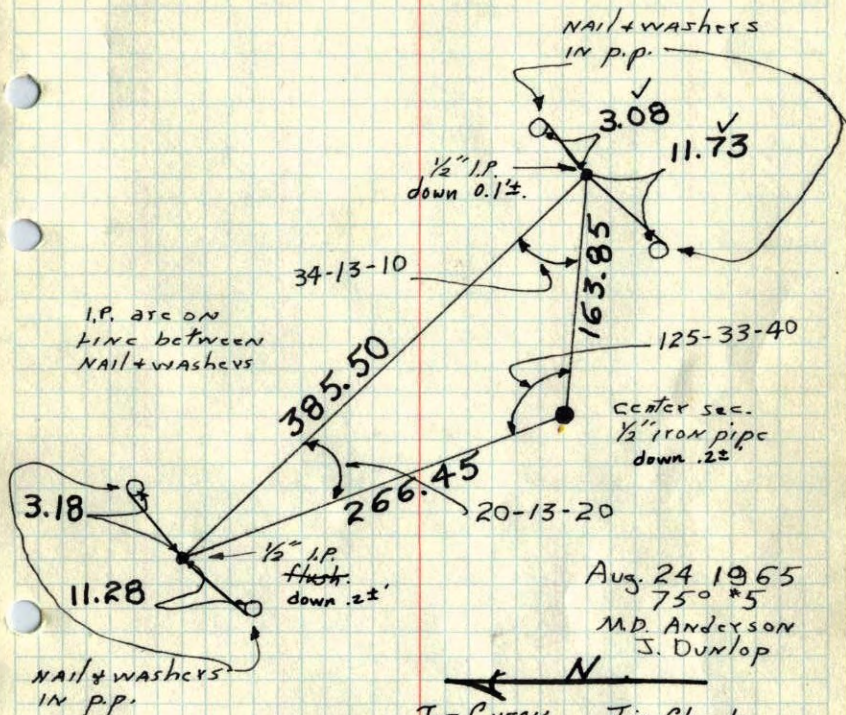

Aug. 24 1965
75° *5
M.D. Anderson
J. Dunlop

- ← N →
- | | |
|--|--|
| TIE CHECK
JUNE 24, 1977
P. SPINERUD
S. BRIEN
J. STEPHENS | Tie Check
August 5, 1970
D. Powell
R. Brien
B. Olson
JULY 18, 1974
R. FARMER
N. DAHL
D. DAHL |
|--|--|

TEMPERATURE CORRECTED
AND HORIZONTALLY
TAPED MEASUREMENTS


ROLAND W. ANDERSON
COUNTY SURVEYOR
ANOKA COUNTY, MINNESOTA

Center of Sec. 36-T31-R24

1/2" iron pipe to be removed by construction

Aug. 24, 1965
M.D. Anderson
J. Dunlop

Temp. 75.0
Tape = 5

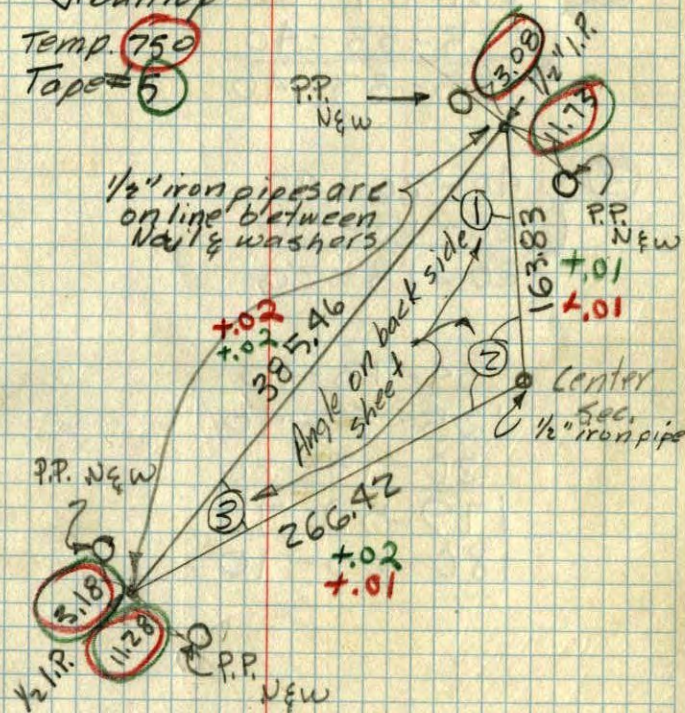

$$\begin{array}{r} \textcircled{1} \quad 68-26-20 \\ \quad \quad 34-13-10 \\ \hline \quad \quad 34-13-10 \end{array}$$

$$\begin{array}{r} \textcircled{2} \quad 251-07-20 \\ \quad \quad 125-33-40 \\ \hline \quad \quad 125-33-40 \end{array}$$

$$\begin{array}{r} \textcircled{3} \quad 40-26-40 \\ \quad \quad 20-13-20 \\ \hline \quad \quad 20-13-20 \end{array}$$

$$\begin{array}{r} 34-13-10 \\ 125-33-40 \\ \hline 20-13-20 \\ 179-59-70 \\ \hline 180-00-10 \end{array}$$