


Center of Section 5 Twp 31 Rge 24
Iron Pipe

26 Mar. 64 - Ran N-S and E-W 1/4
lines to check center before removal
by freeway Const. Found
1/2" I.P. 0.06' West and 0.11'
South of our center.

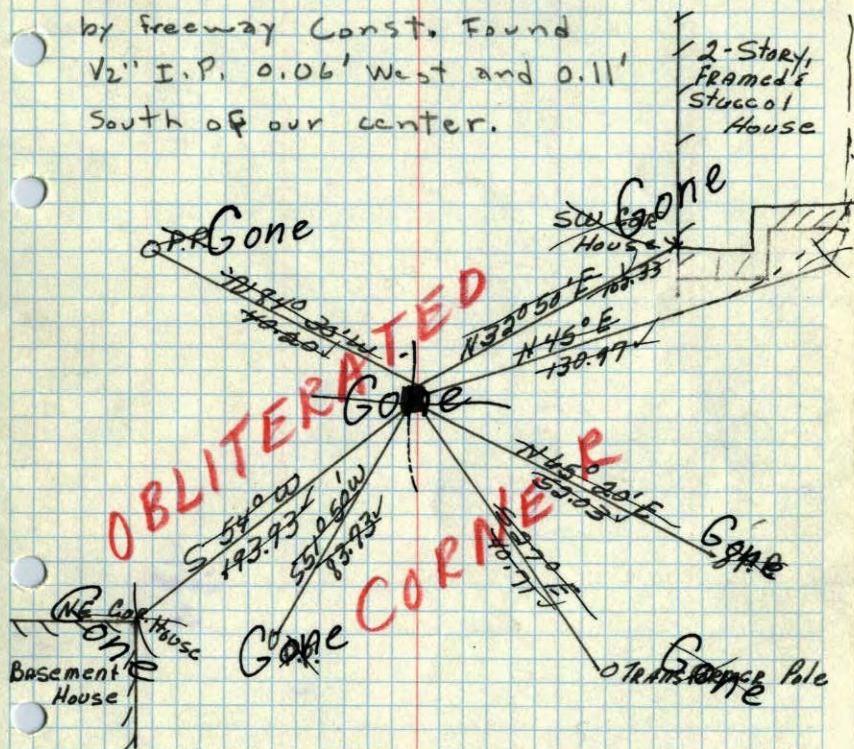


Tie Check
August 18, 1967
D. Potter
D. Powell
(All ties gone)
(Corner gone)

Ties checked
June 4, 1964
M. D. Anderson
R. Carlson
(All ties good)

8-9-55
G.E. Coulter

Center of Section
5-31-24
set Iron Pipe

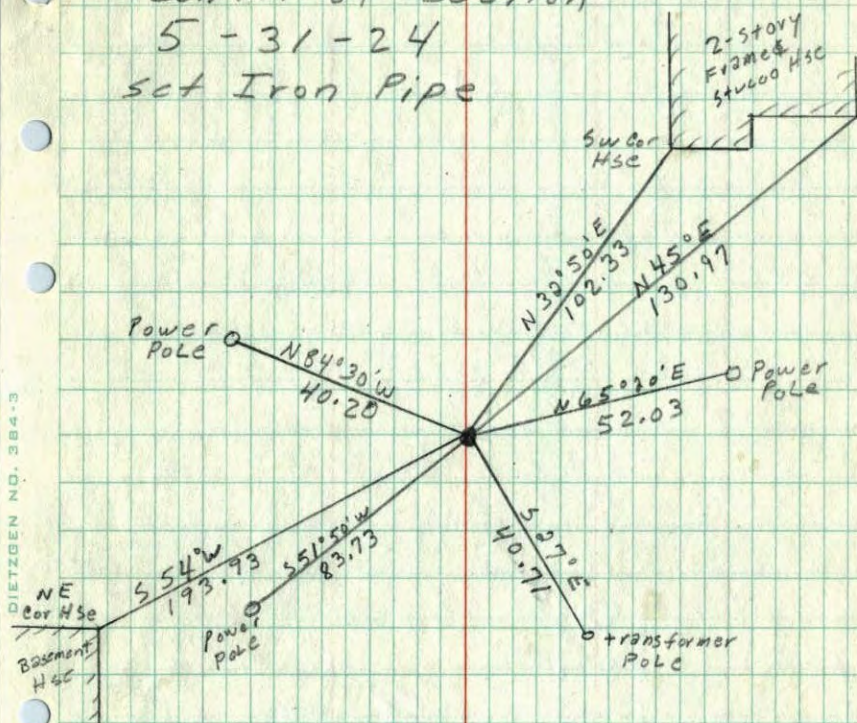

X