


Center Sec. 6-T31-R24

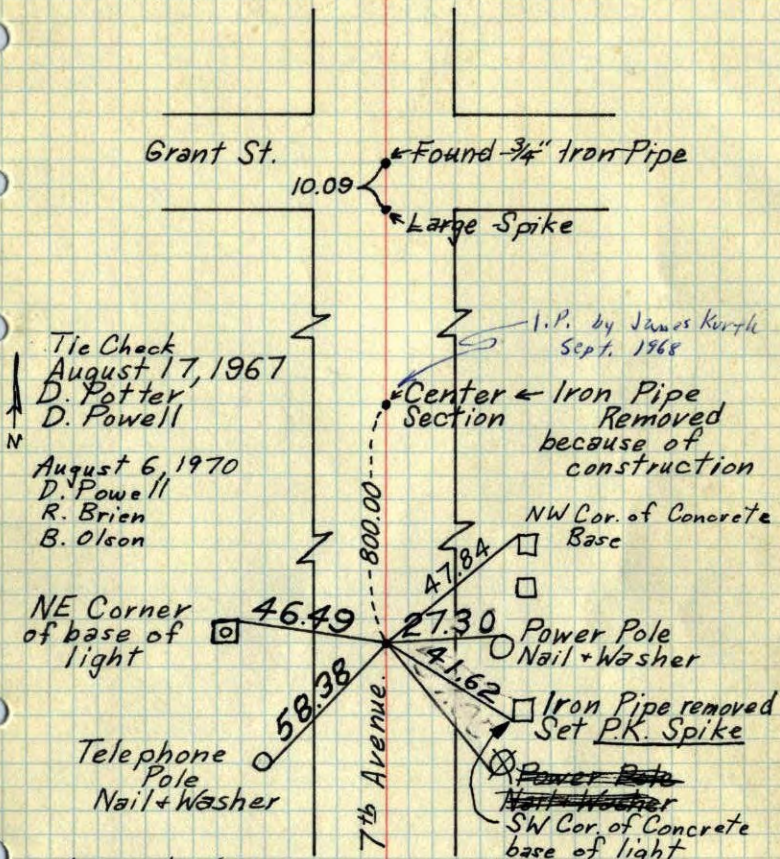


under construction  
6-15-77 R. Spangler

TAPED MEASUREMENTS  
AND HORIZONTALLY  
TEMPERATURE CORRECTED  
AND HORIZONTALLY  
TAPED MEASUREMENTS

ROLAND W. ANDERSON  
COUNTY SURVEYOR  
ANOKA COUNTY, MINNESOTA

X


Center Sec. 6-T31-R24

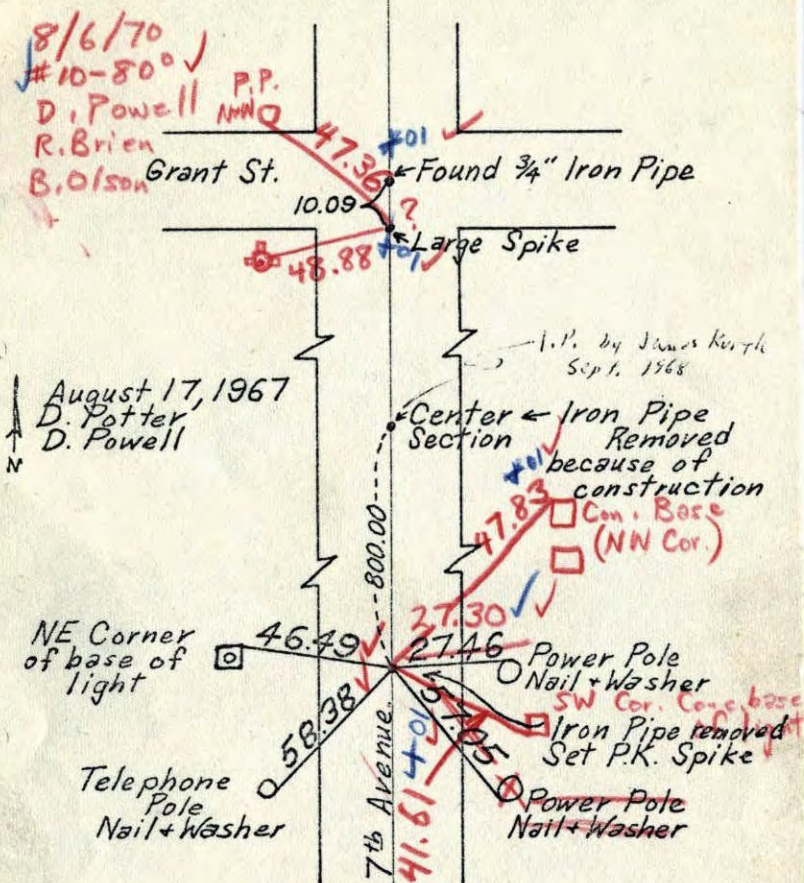

TAPED MEASUREMENTS  
AND HORIZONTALLY  
TEMPERATURE CORRECTED  
AND HORIZONTALLY  
TAPED MEASUREMENTS

ROLAND W. ANDERSON  
COUNTY SURVEYOR  
ANOKA COUNTY, MINNESOTA

CENTER SEC. 6, T31, R24

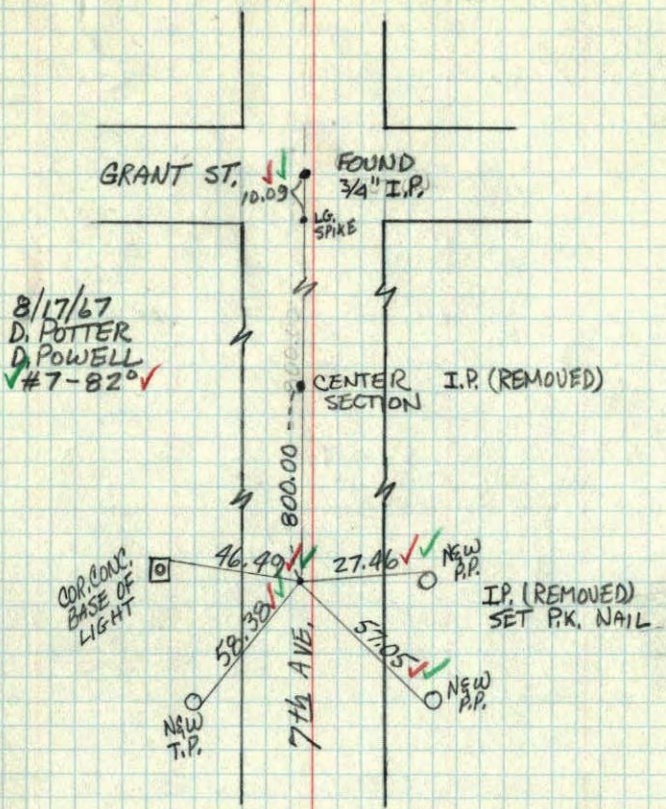

8/17/67  
D. POTTER  
D. POWELL  
✓#7-82°✓

COR. CONC.  
BASE OF  
LIGHT

NEW  
T.P.

7TH AVE.

CENTER SECTION I.P. (REMOVED)

I.P. (REMOVED)  
SET PK. NAIL

46.49

58.38

57.05



















Center Sec. 6-31-24. Anoka Twn.

Found 1" iron pipe @ 7th St.  
FOUND 3/4" I.P.  
Found iron bent replaced with new iron

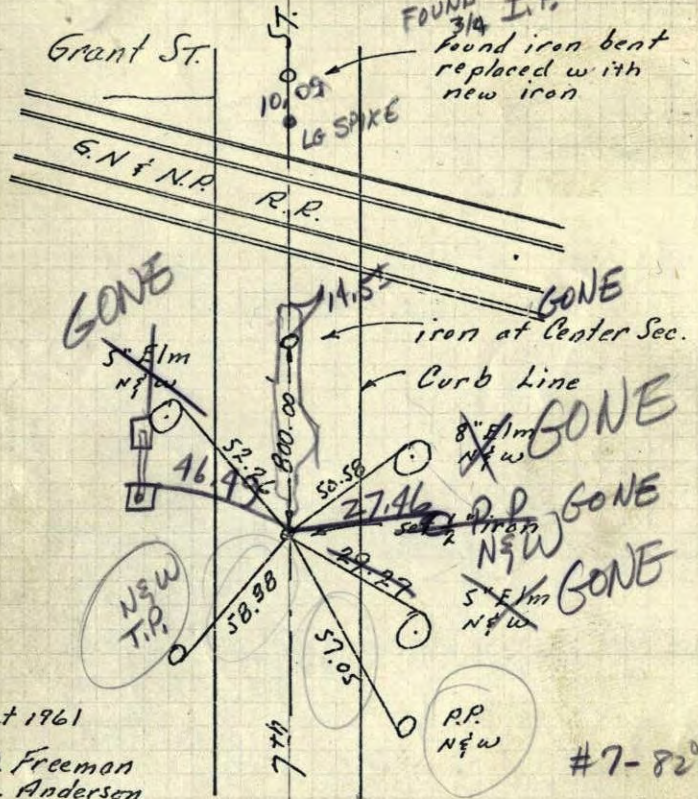

629.5

5 Oct 1961  
R.O. Freeman  
M.D. Anderson

BRIDGED  
AS APPROX. CEN.  
800' SO. INT  
7TH & TYLER  
TEMPERATURE CORRECTED  
AND HORIZONTALLY  
TAPED MEASUREMENTS

ROLAND W. ANDERSON  
COUNTY SURVEYOR  
ANOKA COUNTY, MINNESOTA


#7-82°

114

314

Center Sec. 6-31-24. Anoka Twn.

Found 1" iron pipe & 7<sup>th</sup> St.

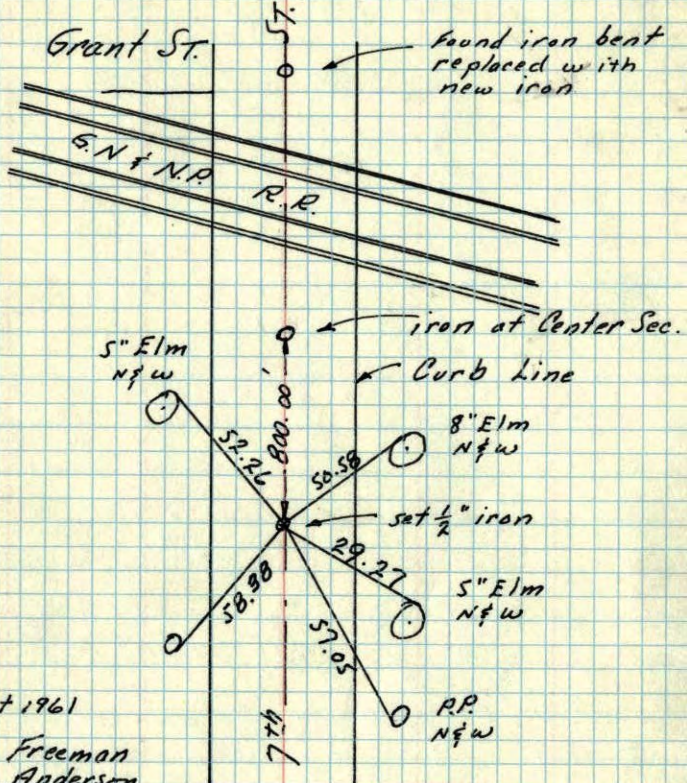

5 Oct 1961  
R.O. Freeman  
M.D. Anderson


TEMPERATURE CORRECTED  
AND HORIZONTALLY  
TAPED MEASUREMENTS

ROLAND W. ANDERSON  
COUNTY SURVEYOR  
ANOKA COUNTY, MINNESOTA

5 Oct 1961  
Freeman Anderson  
+70°

Ties to Center Sec. 6-31-24. Anoka.

Found 1" iron pipe & 7<sup>th</sup> St.

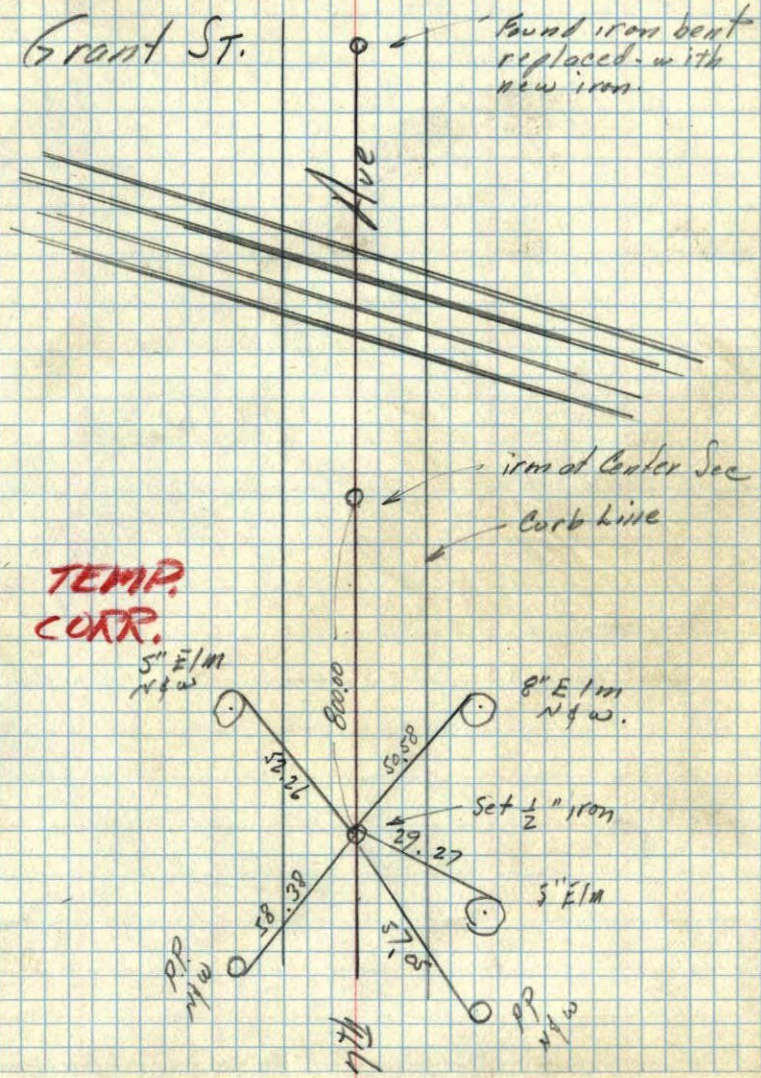

TEMP.  
CORR.