


OK.
as corrected 18

S 1/4 COR. of Sec. 4 T 31. R. 24

Concrete Monument down 13"

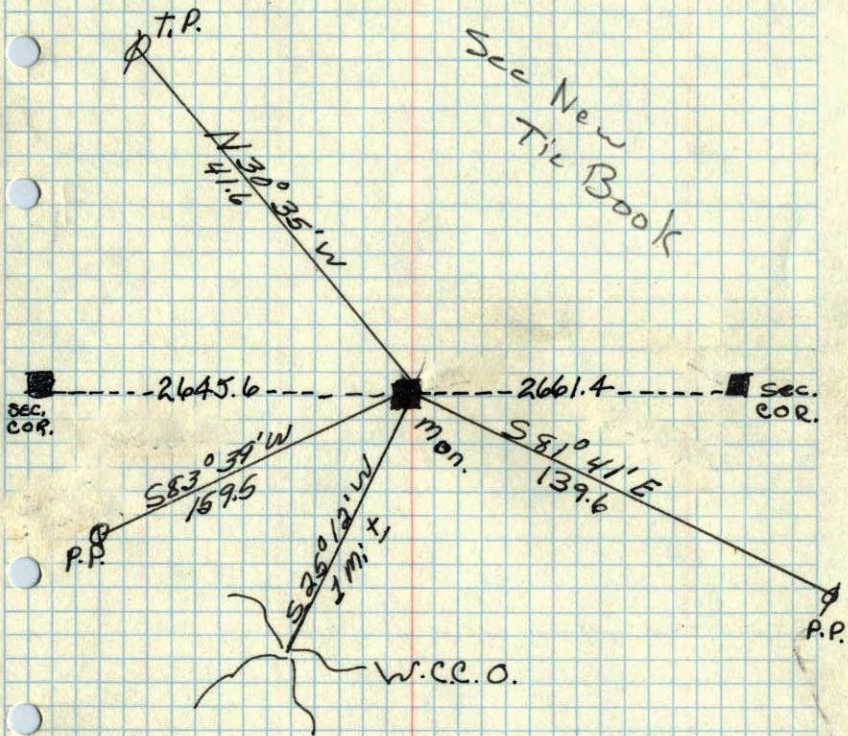

See New
Til Book

Aug. R. 1944
H.A. CARTWRIGHT

$5\frac{1}{4}$ Sec. 9 + 31 R24

