

CERTIFICATE OF LOCATION OF GOVERNMENT CORNER


Corner to Sec. 4 T. 31 R. 29 No. _____

State of Minnesota, }
County of _____ } ss.

I hereby certify that on the _____ day of _____ 19____
I found the SW corner of sec. 4 Anoka Twp.
which was evidenced by _____

and I further certify that to perpetuate the location of such corner I did, at the exact location thereof, place
a permanent marker consisting of _____

I further certify that I established _____
reference or witness monuments consisting of _____
which reference or witness monuments are located in the manner following:

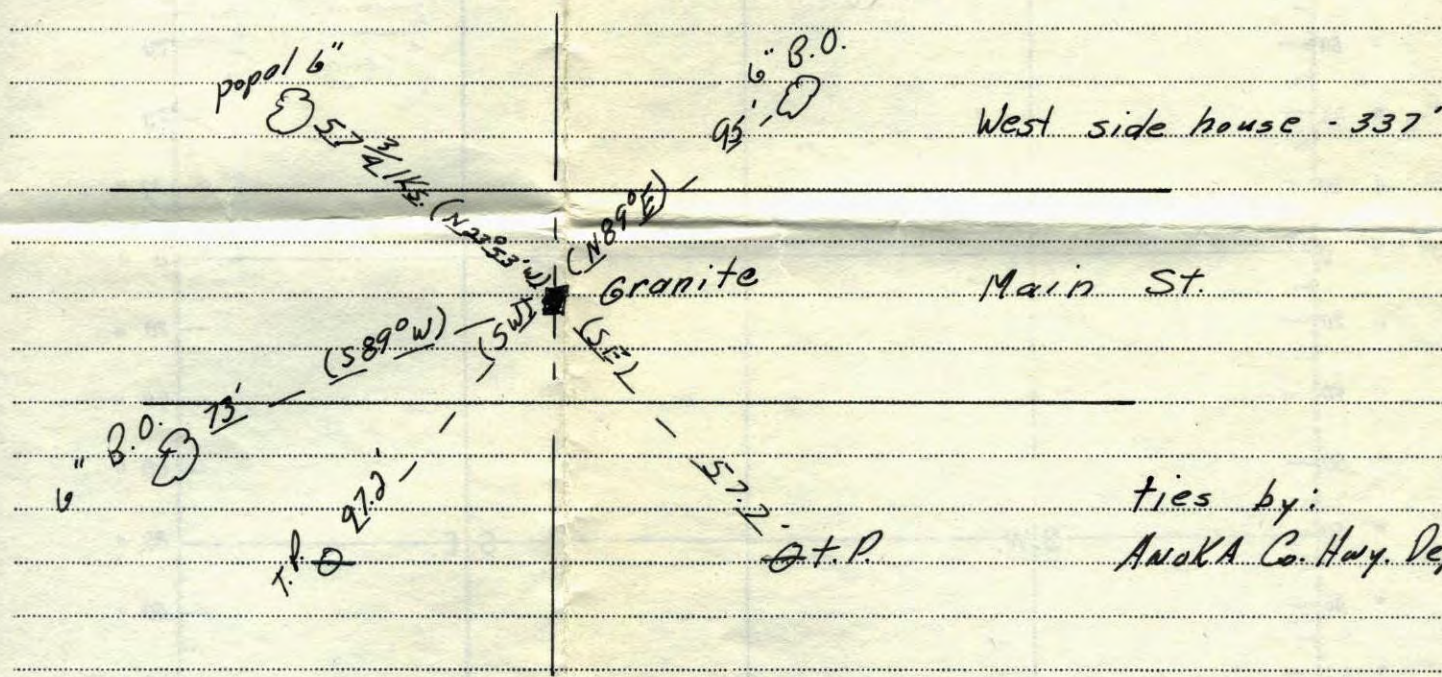

ties by:
Anoka Co. Hwy. Dept.

Dated at _____, Minn., this _____ day of _____ 19____

County Surveyor or Highway Engineer.

OFFICE OF REGISTER OF DEEDS }
County of _____ }

I hereby certify that the within instrument was filed in this office for record on the _____
day of _____ A. D. 19____ at _____ o'clock _____ M.

Register of Deeds.

By _____ Deputy.