

CERTIFICATE OF LOCATION OF GOVERNMENT CORNER

County of Anoka

State of Minnesota


Northeast Corner of Sec. 2 Township 33 Range 23

On the 27th day of September, 1963, the described corner was evidenced by area resurvey

and to perpetuate the location of said corner, at the exact location thereof, a permanent marker was placed consisting of a cast iron monument

AND on the 26th day of June, 2023, said permanent marker was found flush and the ties were updated

Updated reference ties are as shown below.

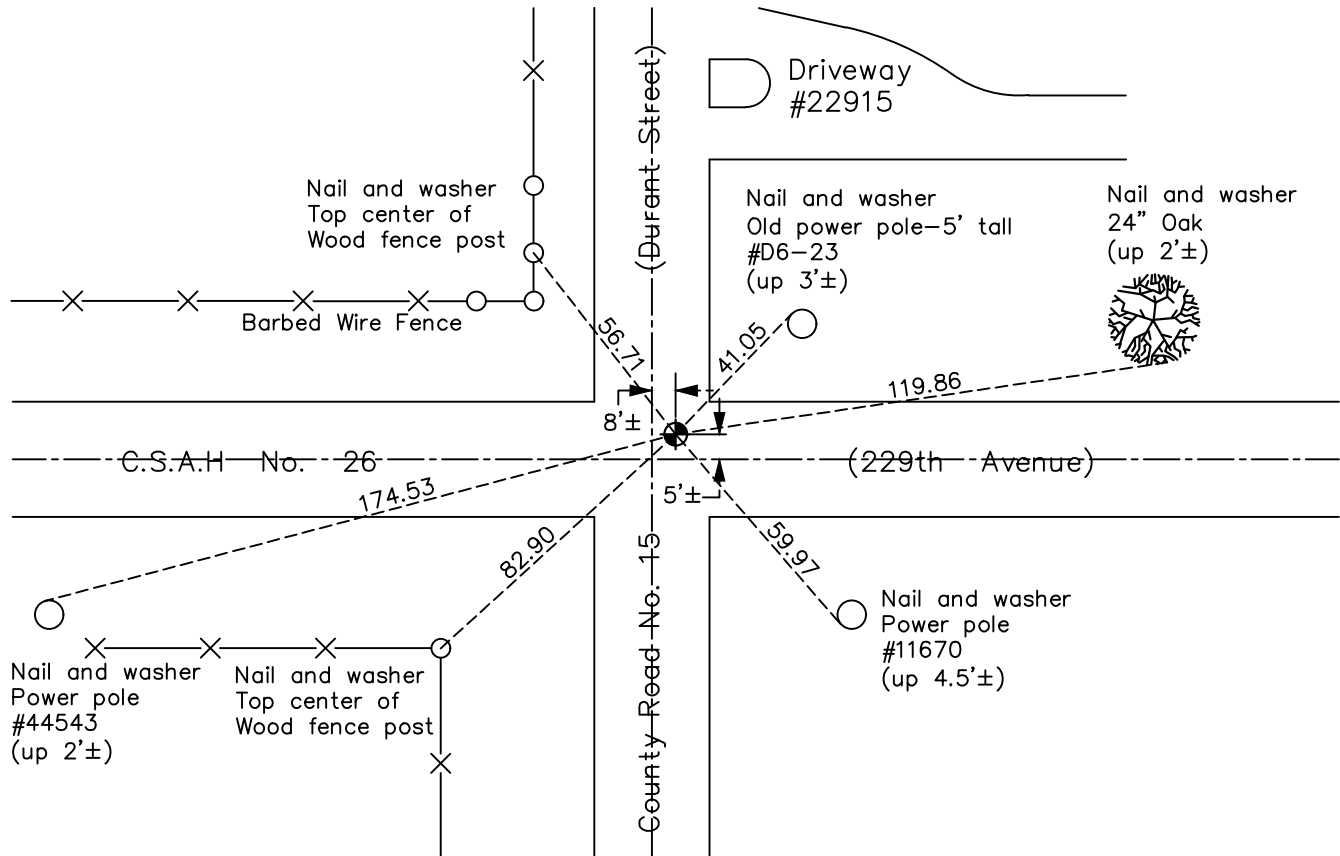

N.A.D. 1983 Coordinates
(1996 Adjustment)

County Project Coordinates	
Northing	<u>227591.9120</u>
Easting	<u>526747.8993</u>
Date	<u>3/26/02</u>

Revision Date
10/09/2023

I hereby certify that this United States public land survey monument record is correct and complete to the best of my knowledge and belief.

David Zieglmeier Date 12/11/23

David Zieglmeier Anoka County Surveyor
Minnesota License Number 46179

HISTORY OF GOVERNMENT CORNER

Page No. 3

County of Anoka

State of Minnesota

Northeast Corner of Sec. 2 Township 33 Range 23

CORNER HISTORY:

September 27, 1963 - Set cast iron monument flush using area resurvey and established ties to the monument.

July 10, 1967 - Found cast iron monument and updated ties.

June 16, 1970 - Found cast iron monument and updated ties.

August 12, 1971 - Found cast iron monument and updated ties.

July 22, 1974 - Found cast iron monument and updated ties.

June 27, 1977 - Found cast iron monument and updated ties.

June 8, 1981 - Found cast iron monument and updated ties.

June 11, 1984 - Found cast iron monument and updated ties.

August 18, 1986 - Found cast iron monument and updated ties.

July 30, 1992 - Found cast iron monument and updated ties.

August 5, 1997 - Found cast iron monument and updated ties.

March 26, 2002 - Found cast iron monument, established NAD 1983 (1996 adj.) Anoka County project coordinates by static GPS methods and updated ties.

April 23, 2012 - Found cast iron monument, verified position by VRS GPS methods and updated ties.

June 30, 2016 - Found cast iron monument. Set construction ties, updated corner ties, verified position by VRS GPS methods and removed monument prior to road construction.

November 3, 2016 - Set cast iron monument flush after road construction, verified position by static GPS methods and corner ties.

May 31, 2018 - Found cast iron monument flush, verified position by VRS GPS methods and updated ties.

September 29, 2021 - Found cast iron monument flush, verified position by VRS GPS methods & updated ties.

June 26, 2023 - Found cast iron monument flush, verified position by ACS RTK GPS method & updated ties.