

CERTIFICATE OF LOCATION OF GOVERNMENT CORNER

County of Anoka

State of Minnesota



Northwest Corner of Sec. 3 Township 33 Range 23

On the 29th day of November, 1963, the described corner was evidenced by a 3/4" iron pipe

and to perpetuate the location of said corner, at the exact location thereof, a permanent marker was placed consisting of a cast iron monument on centerline

AND on the 26th day of June, 2023, said permanent marker was found a cast iron monument on centerline and the ties were updated

Updated reference ties are as shown below.

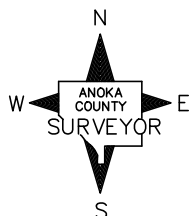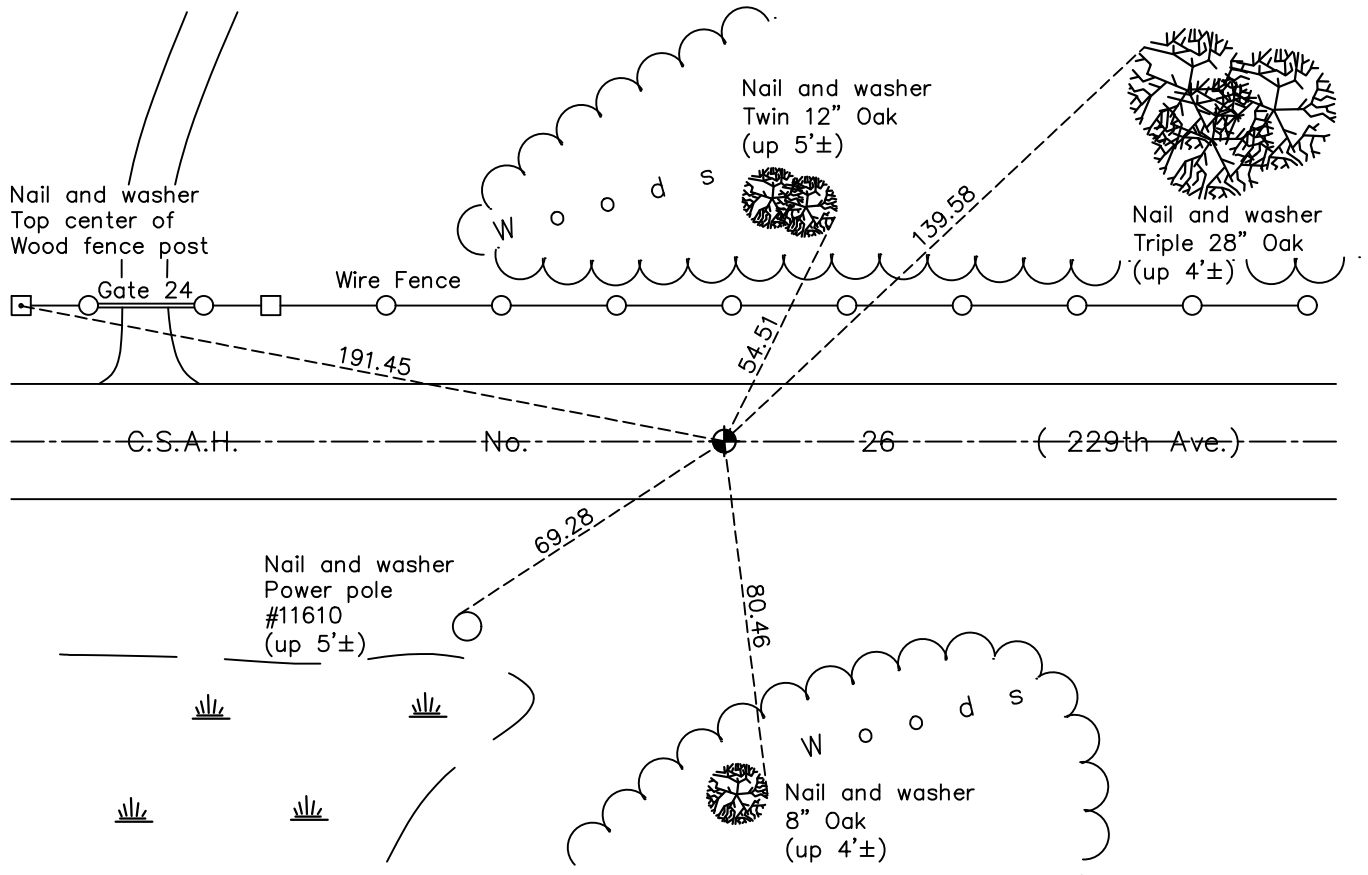

Revision Date
10/09/2023

N.A.D. 1983 Coordinates
(1996 Adjustment)

County Project Coordinates	
Northing	<u>227559.4113</u>
Easting	<u>516193.3948</u>
Date	<u>3/26/02</u>

I hereby certify that this United States public land survey monument record is correct and complete to the best of my knowledge and belief.

David Zieglmeier Date 12/11/23

David Zieglmeier Anoka County Surveyor
 Minnesota License Number 46179

HISTORY OF GOVERNMENT CORNER

Page No. 7

County of Anoka

State of Minnesota

Northwest Corner of Sec. 3 Township 33 Range 23

CORNER HISTORY:

November 29, 1963 - Found 3/4" iron pipe down 0.1'± set by Ray Prasch and Jerry Cayar. Established ties to the monument.

July 18, 1967 - Set cast iron monument flush and updated ties.

June 17, 1970 - Found cast iron monument and updated ties.

August 12, 1971 - Found cast iron monument, raised and updated ties.

July 22, 1974 - Found cast iron monument and updated ties.

June 27, 1977- Found cast iron monument and updated ties.

June 8, 1981 - Found cast iron monument and updated ties.

June 12, 1984 - Found cast iron monument and updated ties.

August 18, 1986 - Found cast iron monument and updated ties.

July 31, 1992 - Found cast iron monument and updated ties.

August 4, 1997- Found cast iron monument and updated ties.

May 25, 2000 - Found cast iron monument and updated ties.

March 26, 2002 - Found cast iron monument, established NAD 1983 (1996 adj.) Anoka County project coordinates by static GPS methods and updated ties.

July 24, 2012 - Found cast iron monument, verified position by VRS GPS methods and updated ties.

June 29, 2016 - Found cast iron monument, set construction ties, verified position by VRS GPS methods and updated ties prior to road construction. Removed cast iron monument.

October 2016 - Set cast iron monument flush after road construction, verified position by static GPS methods and corner ties.

April 12, 2018 - Found cast iron monument, verified position by VRS GPS methods and updated the ties.

September 30, 2021 - Found cast iron monument, verified position by VRS GPS methods and updated ties.

June 26, 2023 - Found cast iron monument, verified position by ACS RTK GPS method and updated ties.