

CERTIFICATE OF LOCATION OF GOVERNMENT CORNER

County of Anoka

State of Minnesota



West 1/4 Corner of Sec. 5 Township 33 Range 23

On the 8th day of April, 1981, the described corner was evidenced by area resurvey

and to perpetuate the location of said corner, at the exact location thereof, a permanent marker was placed consisting of a red and white 2" square steel Telspar monument with a sign attached
(up 3'±)

AND on the 14th day of March, 2022, said permanent marker was found and no ties were available. Verified position by VRS GPS methods.

Updated reference ties are as shown below.

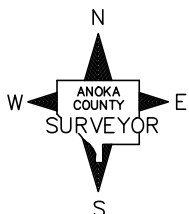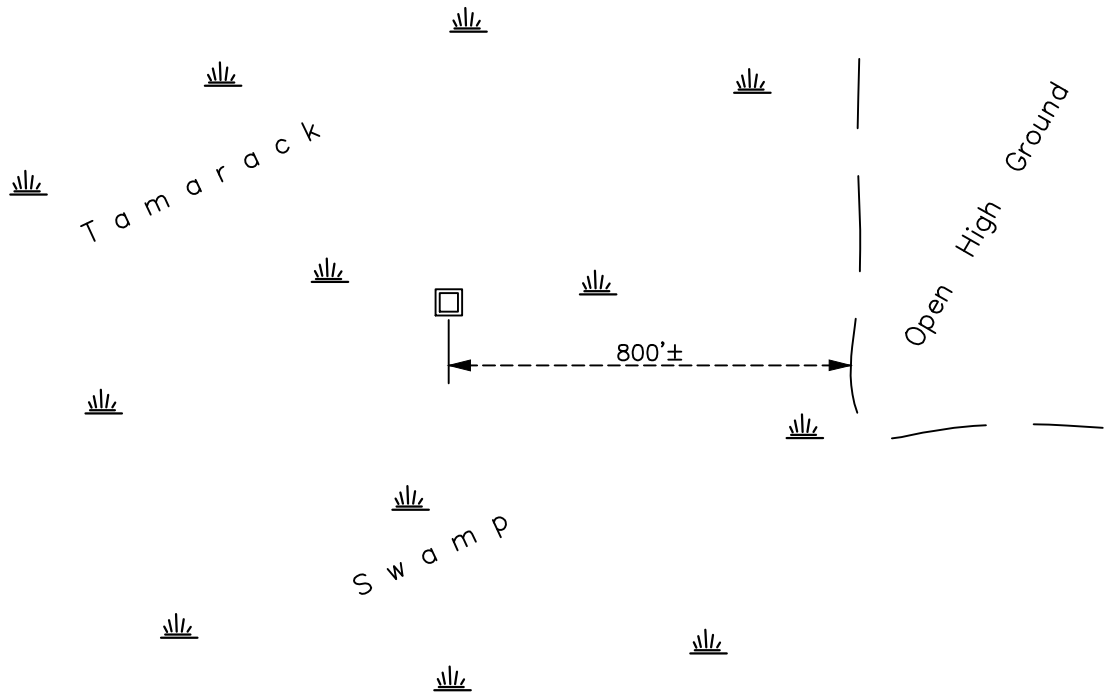

Revision Date

3/30/2022

N.A.D. 1983 Coordinates
(1996 Adjustment)

County Project Coordinates	
Northing	<u>224925.0159</u>
Easting	<u>505375.1827</u>
Date	<u>3/25/03</u>

I hereby certify that this United States public land survey monument record is correct and complete to the best of my knowledge and belief.

David Zieglmeier Date 1/19/23

David Zieglmeier Anoka County Surveyor
Minnesota License Number 46179

HISTORY OF GOVERNMENT CORNER

Page No. 9

County of Anoka

State of Minnesota

West 1/4 Corner of Sec. 5 Township 33 Range 23

CORNER HISTORY:

April 8, 1981 - Set red and white iron pipe up 3'± using area resurvey and established ties to monument.

November 19, 1987 - Found red and white iron pipe in good condition, ties were all gone.

January 23, 2013 - Found red and white 2" square steel telspar up 3'± (sign attached) and verified position by VRS GPS methods. No ties available.

March 8, 2019 - Found red and white 2" square steel telspar up 3'± (sign attached) and verified position by VRS GPS methods. No ties available.

March 14, 2022 - Found red and white 2" square steel telspar up 3'± (sign attached) and verified position by VRS GPS methods. No ties available.