

CERTIFICATE OF LOCATION OF GOVERNMENT CORNER

County of Anoka

State of Minnesota


South 1/4 Corner of Sec. 6 Township 33 Range 23

On the 2nd day of August, 1968, the described corner was evidenced by an iron pipe set by N.C. Hoium

and to perpetuate the location of said corner, at the exact location thereof, a permanent marker was placed consisting of a cast iron monument on September 9th 1969.

AND on the 18th day of May, 2023, said permanent marker was set cast iron monument after road construction, verified using RTK GPS methods. Updated ties.

Updated reference ties are as shown below.

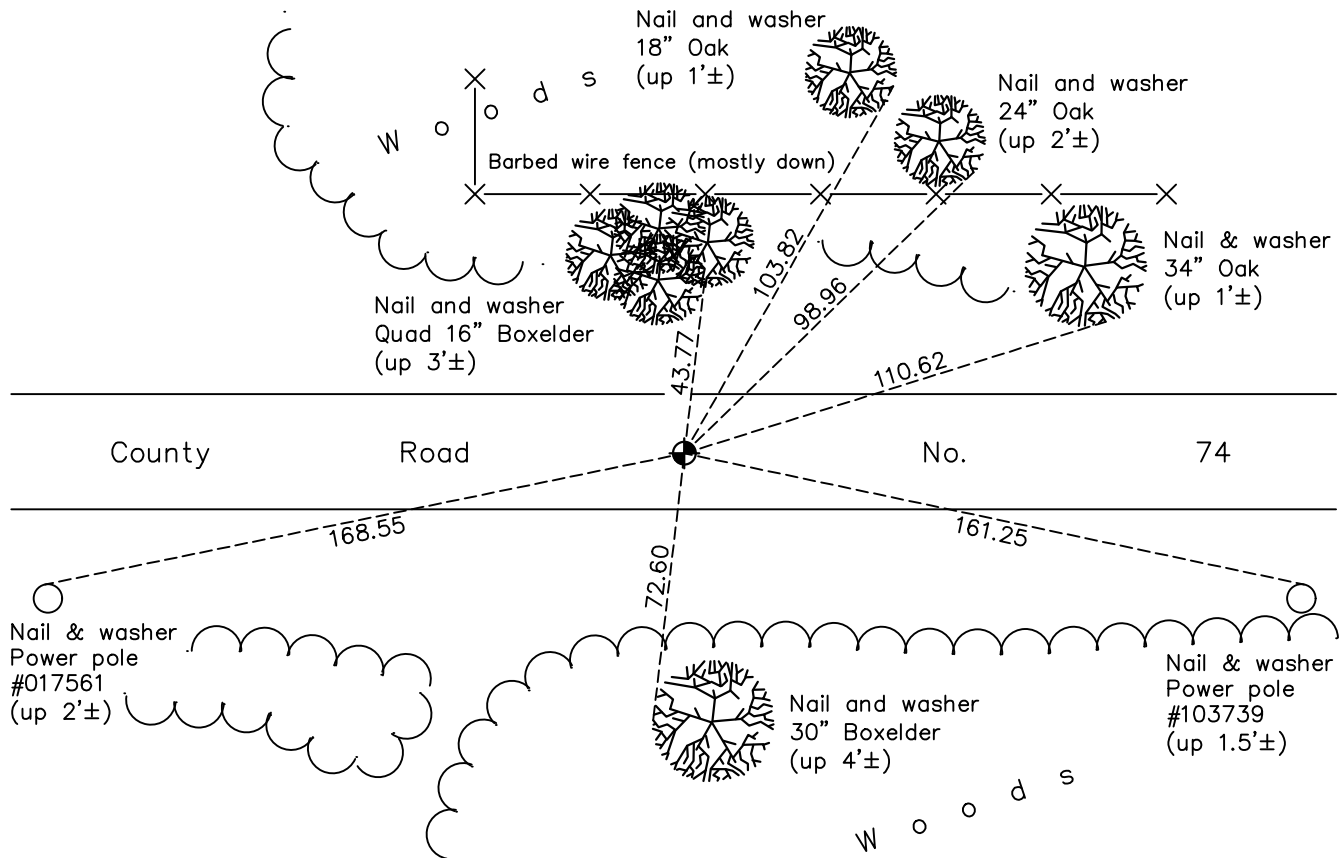

Revision Date
5/31/2023

N.A.D. 1983 Coordinates
 (1996 Adjustment)

County Project Coordinates	
Northing	<u>222269.7014</u>
Easting	<u>502458.3100</u>
Date	<u>4/04/02</u>

I hereby certify that this United States public land survey monument record is correct and complete to the best of my knowledge and belief.
David Zieglmeier Date 6/28/23
 David Zieglmeier Anoka County Surveyor
 Minnesota License Number 46179

HISTORY OF GOVERNMENT CORNER

Page No. 28

County of Anoka

State of Minnesota

South 1/4 Corner of Sec. 6 Township 33 Range 23

CORNER HISTORY:

August 2, 1968 - Set 3/4" iron pipe and established ties to monument.

September 9, 1969 - Replaced iron pipe with cast iron monument flush and updated ties.

7/22/74, 6/29/77, 6/10/81, 6/12/84, 6/1/87, 8/6/92 - Found cast iron monument and updated ties.

June 10, 1998 - Found cast iron monument broken. Replaced broken cast iron monument and updated ties.

May 24, 1999 - Found cast iron monument, set construction ties and removed prior to road construction.

May 18, 2000 - Found cast iron monument and updated ties.

April 4, 2002 - Found cast iron monument and updated ties. Established NAD 1983 (1996 adj.) Anoka County project coordinates by static GPS methods.

1/18/13, 5/1/18, 10/22/21 - Found cast iron monument. Verified position by VRS GPS methods. Updated ties.

May 18, 2023 - set cast iron monument after road construction, verified using RTK GPS methods. Updated ties. Job no. 22-131