

CERTIFICATE OF LOCATION OF GOVERNMENT CORNER

County of Anoka

State of Minnesota



North 1/4 Corner of Sec. 15 Township 33 Range 23

On the 12th day of July, 1973, the described corner was evidenced by an area resurvey

and to perpetuate the location of said corner, at the exact location thereof, a permanent marker was placed consisting of a red and white iron pipe

AND on the 21st day of March, 2023, said permanent marker was found and lowered to 1.5'±
Verified position to published coordinates, verified ties to historical ties. Ties updated after adjustment.

Updated reference ties are as shown below.

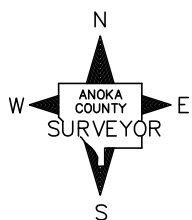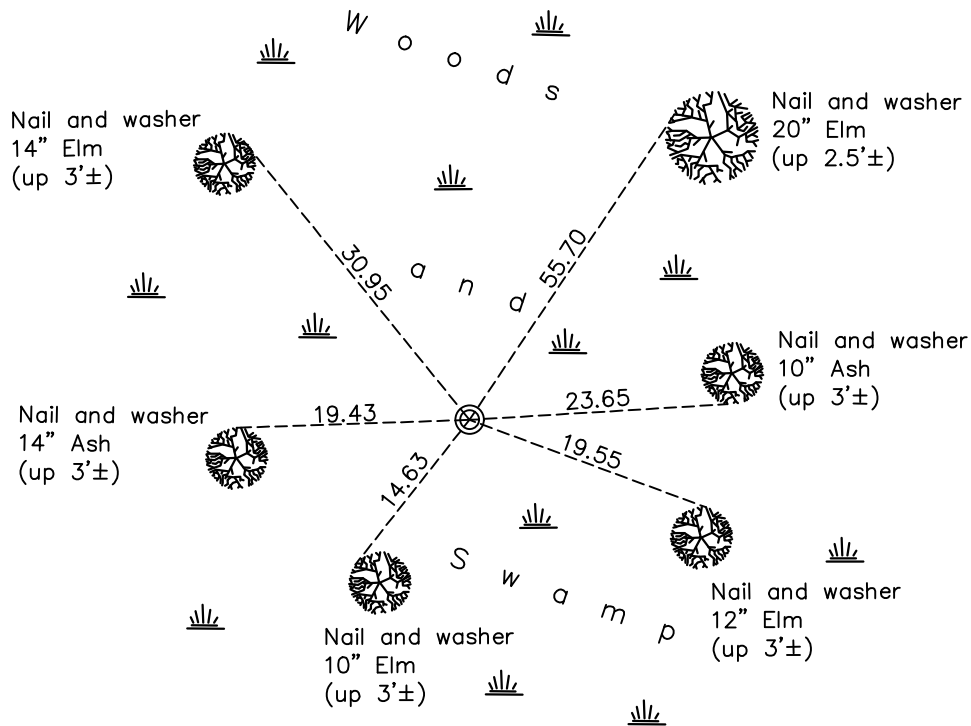

Revision Date
4/05/2023

N.A.D. 1983 Coordinates
(1996 Adjustment)

County Project Coordinates	
Northing	216917.3610
Easting	518297.9785
Date	3/27/03

I hereby certify that this United States public land survey monument record is correct and complete to the best of my knowledge and belief.
David Zieglmeier Date 12/11/23
 David Zieglmeier Anoka County Surveyor
 Minnesota License Number 46179

HISTORY OF GOVERNMENT CORNER

Page No. 39

County of Anoka

State of Minnesota

North 1/4 Corner of Sec. 15 Township 33 Range 23

CORNER HISTORY:

July 12, 1973 - Set red and white iron pipe using area resurvey and established ties to the iron pipe.

August 15, 1974 - Found red and white iron pipe and updated ties.

July 1, 1977 - Found red and white iron pipe and updated ties.

June 8, 1987 - Found red and white iron pipe and updated ties.

February 18, 1992 - Found red and white iron pipe and updated ties.

March 27, 2003 - Found red and white iron pipe, established NAD 1983 (1996 adj.) Anoka County project coordinates by static GPS methods and updated ties.

January 25, 2013 - Found red and white iron pipe up 3'± and updated ties.

March 4, 2022 - Found red and white iron pipe up 3'±, verified position by VRS GPS method. Updated ties.

March 21, 2023 - Found red and white iron pipe up 3'± w/ sign. Lowered pipe to 1.5'± and verified position correct to published coordinates with ACS RTK GPS method and verifying ties to historical. Ties updated after adjustment.