

CERTIFICATE OF LOCATION OF GOVERNMENT CORNER

County of Anoka

State of Minnesota


Southwest Corner of Sec. 8 Township 33 Range 23

On the 23rd day of February, 1962, the described corner was evidenced by a cast iron monument (down 1'±)

and to perpetuate the location of said corner, at the exact location thereof, a permanent marker was placed consisting of a cast iron monument

AND on the 8th day of October, 2021, said permanent marker was found flush and the ties were updated

Updated reference ties are as shown below.

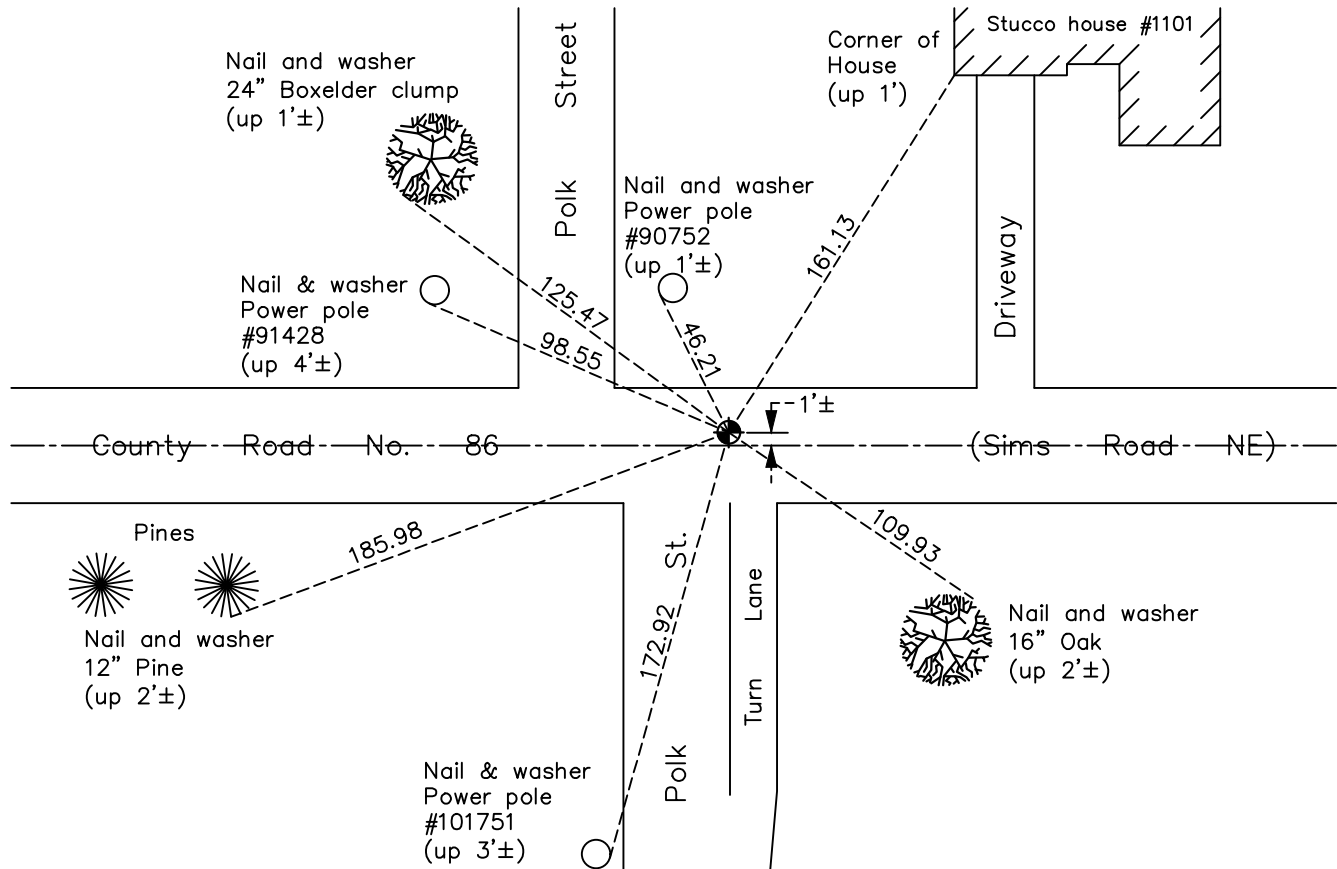

Revision Date
1/10/2022

N.A.D. 1983 Coordinates
(1996 Adjustment)

County Project Coordinates	
Northing	<u>217011.4609</u>
Easting	<u>505010.9149</u>
Date	<u>4/05/02</u>

I hereby certify that this United States public land survey monument record is correct and complete to the best of my knowledge and belief.

David Zieglmeier Date 1/20/23

David Zieglmeier Anoka County Surveyor
Minnesota License Number 46179

HISTORY OF GOVERNMENT CORNER

Page No. 44

County of Anoka

State of Minnesota

Southwest Corner of Sec. 8 Township 33 Range 23

CORNER HISTORY:

February 23, 1962 - Found cast iron monument down 1'± and established ties to monument.

September 24, 1964 - Found cast iron monument and updated ties.

June 23, 1970 - Found cast iron monument down 1'± and updated ties.

June 20, 1977 - Found cast iron monument and updated ties.

September 20, 1979 - Found cast iron monument down 1'± and updated ties.

December 27, 1979 - Found cast iron monument and set construction ties prior to road construction.

June 10, 1981 - Found cast iron monument and updated ties.

August 11, 1981 - Found cast iron monument and updated ties.

July 19, 1982 - Replaced cast iron monument flush and updated ties.

June 2, 1987 - Found cast iron monument and updated ties.

August 7, 1992 - Found cast iron monument and updated ties.

July 30, 1997 - Found cast iron monument and updated ties.

May 16, 2000 - Found cast iron monument and updated ties.

April 5, 2002 - Established NAD 1983 (1996 adj.) Anoka County project coordinates by static GPS methods.

April 29, 2010 - Found cast iron monument, updated ties and removed prior to road construction.

July 20, 2010 - Set temporary P.K. nail and updated ties to the P.K. nail after construction.

August 12, 2010 - Replaced P.K. nail with a cast iron monument and updated ties.

January 25, 2013 - Found cast iron monument. Verified position by VRS GPS methods. Updated ties.

April 23, 2018 - Found cast iron monument flush. Verified position by VRS GPS methods. Updated ties.

October 8, 2021 - Found cast iron monument flush. Verified position by VRS GPS methods. Updated ties.