

CERTIFICATE OF LOCATION OF GOVERNMENT CORNER

County of Anoka

State of Minnesota


East 1/4 Corner of Sec. 15 Township 33 Range 23

On the 27th day of June, 1973, the described corner was evidenced by area resurvey

and to perpetuate the location of said corner, at the exact location thereof, a permanent marker was placed consisting of a cast iron monument with a sign and post on the north side

AND on the 21st day of October, 2021, said permanent marker was found down 1'± and the ties were updated

Updated reference ties are as shown below.

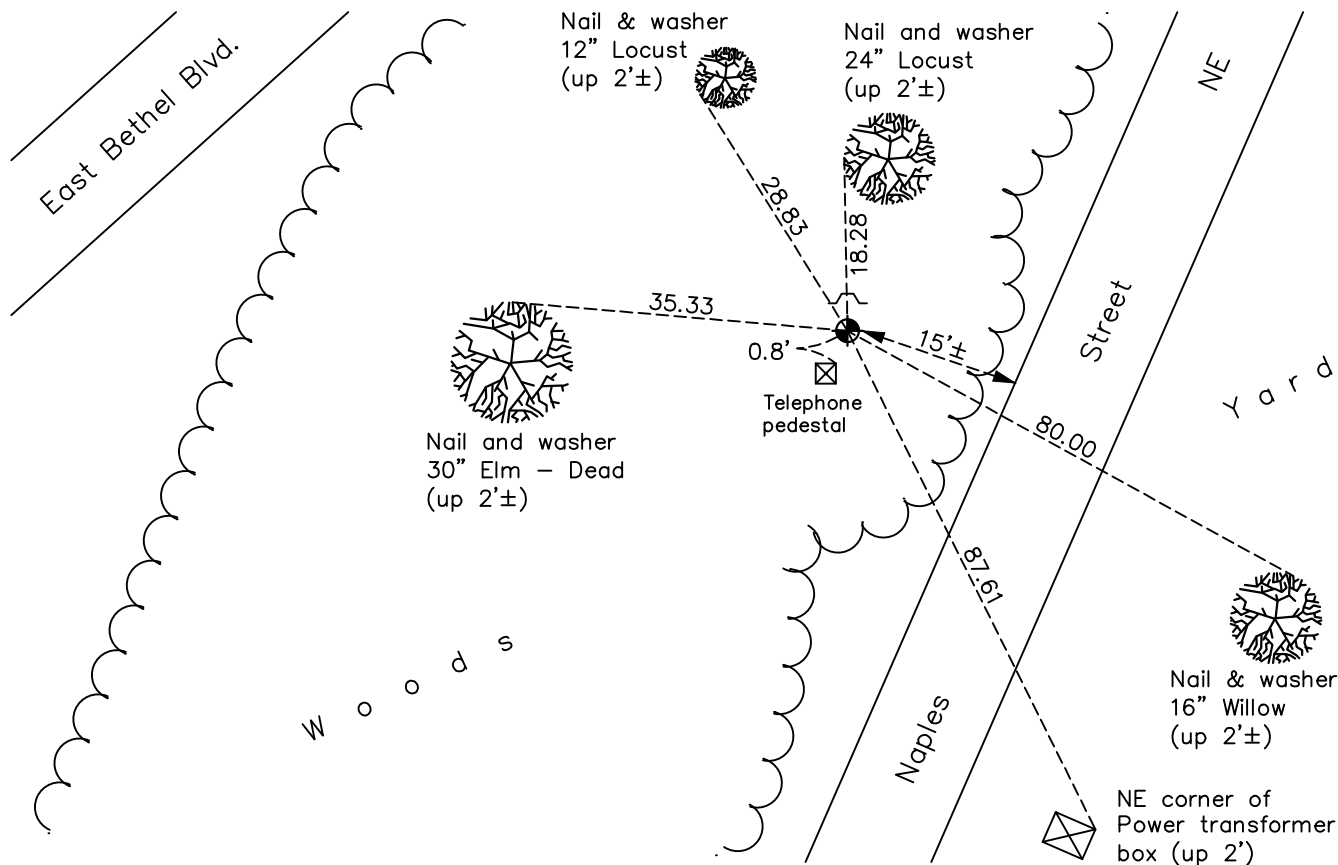

Revision Date

1/10/2022

N.A.D. 1983 Coordinates
(1996 Adjustment)

County Project Coordinates	
Northing	<u>214240.6301</u>
Easting	<u>520943.0451</u>
Date	<u>4/05/02</u>

I hereby certify that this United States public land survey monument record is correct and complete to the best of my knowledge and belief.

David Zieglmeier Date 1/20/23

David Zieglmeier Anoka County Surveyor
Minnesota License Number 46179

HISTORY OF GOVERNMENT CORNER

Page No. 51

County of Anoka

State of Minnesota

East 1/4 Corner of Sec. 15 Township 33 Range 23

CORNER HISTORY:

June 27, 1973 - Found 1-1/2" iron pipe used in area resurvey and replaced with a cast iron monument. Established ties to monument.

August 7, 1974 - Found cast iron monument and updated ties.

July 1, 1977 - Found cast iron monument and updated ties.

June 9, 1981 - Found cast iron monument and updated ties.

June 19, 1984 - Found cast iron monument and updated ties.

August 4, 1992 - Found cast iron monument and updated ties.

August 4, 1997 - Found cast iron monument and updated ties.

August 10, 2000 - Found cast iron monument and updated ties.

April 5, 2002 - Established NAD 1983 (1996 adj.) Anoka County project coordinates by static GPS methods.

December 28, 2012 - Found cast iron monument. Verified position by VRS GPS methods. Updated ties.

April 30, 2018 - Found cast iron monument down 1'±. Verified position by VRS GPS methods. Updated ties.

October 21, 2021 - Found cast iron monument down 1'±. Verified position by VRS GPS methods. Updated ties.