

CERTIFICATE OF LOCATION OF GOVERNMENT CORNER

County of Anoka

State of Minnesota


North $\frac{1}{4}$ Corner of Sec. 24 Township 33 Range 23

On the 28th day of October, 1970, the described corner was evidenced by area resurvey

and to perpetuate the location of said corner, at the exact location thereof, a permanent marker was placed consisting of a cast iron monument with a sign and post on the north side

AND on the 1st day of November, 2021, said permanent marker was found flush and the
ties were updated

Updated reference ties are as shown below.

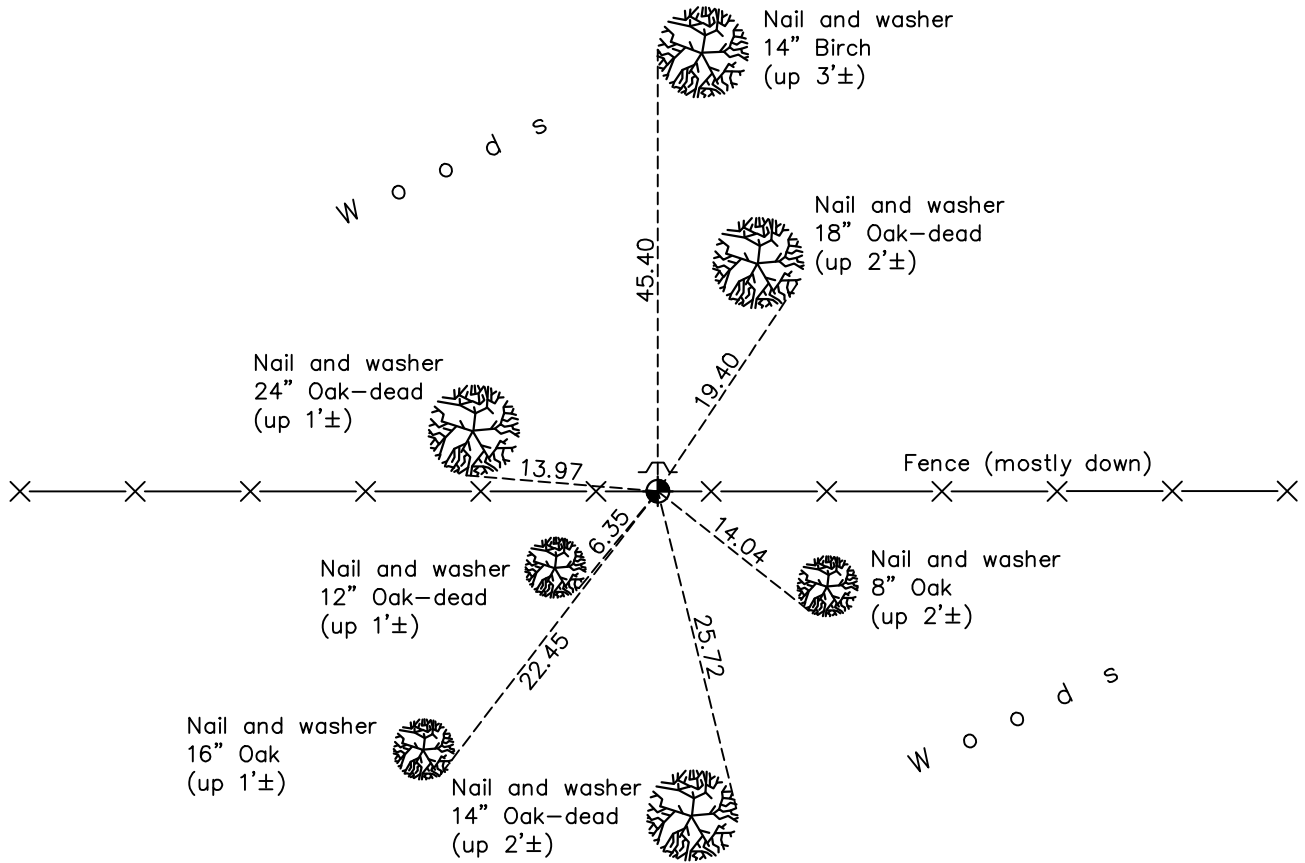

Revision Date
1/10/2022

N.A.D. 1983 Coordinates
 (1996 Adjustment)

| County Project Coordinates | |
|----------------------------|--------------------|
| Northing | <u>211485.1086</u> |
| Easting | <u>529049.9853</u> |
| Date | <u>3/12/03</u> |

I hereby certify that this United States public land survey monument record is correct and complete to the best of my knowledge and belief.

David Zieglmeier Date 1/20/23

David Zieglmeier Anoka County Surveyor
 Minnesota License Number 46179

HISTORY OF GOVERNMENT CORNER

Page No. 55

County of Anoka

State of Minnesota

North 1/4 Corner of Sec. 24 Township 33 Range 23

CORNER HISTORY:

October 28, 1970 - Set cast iron monument flush using area resurvey and established ties to monument.

July 30, 1974 - Found cast iron monument and updated ties.

July 5, 1977 - Found cast iron monument and updated ties.

June 22, 1981 - Found cast iron monument and updated ties.

June 18, 1984 - Found cast iron monument and updated ties.

June 3, 1987 - Found cast iron monument and updated ties.

August 24, 1992 - Found cast iron monument and updated ties.

March 12, 2003 - Established NAD 1983 (1996 adj.) Anoka County project coordinates by static GPS methods.

August 2, 2012 - Found cast iron monument and updated ties.

May 4, 2018 - Found cast iron monument flush and updated ties.

November 1, 2021 - Found cast iron monument flush, verified position by VRS GPS methods and updated ties.