

# CERTIFICATE OF LOCATION OF GOVERNMENT CORNER

County of Anoka

State of Minnesota


## South 1/4 Corner of Sec. 15 Township 33 Range 23

On the 2nd day of July, 1973, the described corner was evidenced by area resurvey

and to perpetuate the location of said corner, at the exact location thereof, a permanent marker was placed consisting of a red and white iron pipe with a sign attached facing north

AND on the 3rd day of March, 2022, said permanent marker was found up 3'± with the paint mostly worn off. Ties were updated.

Updated reference ties are as shown below.

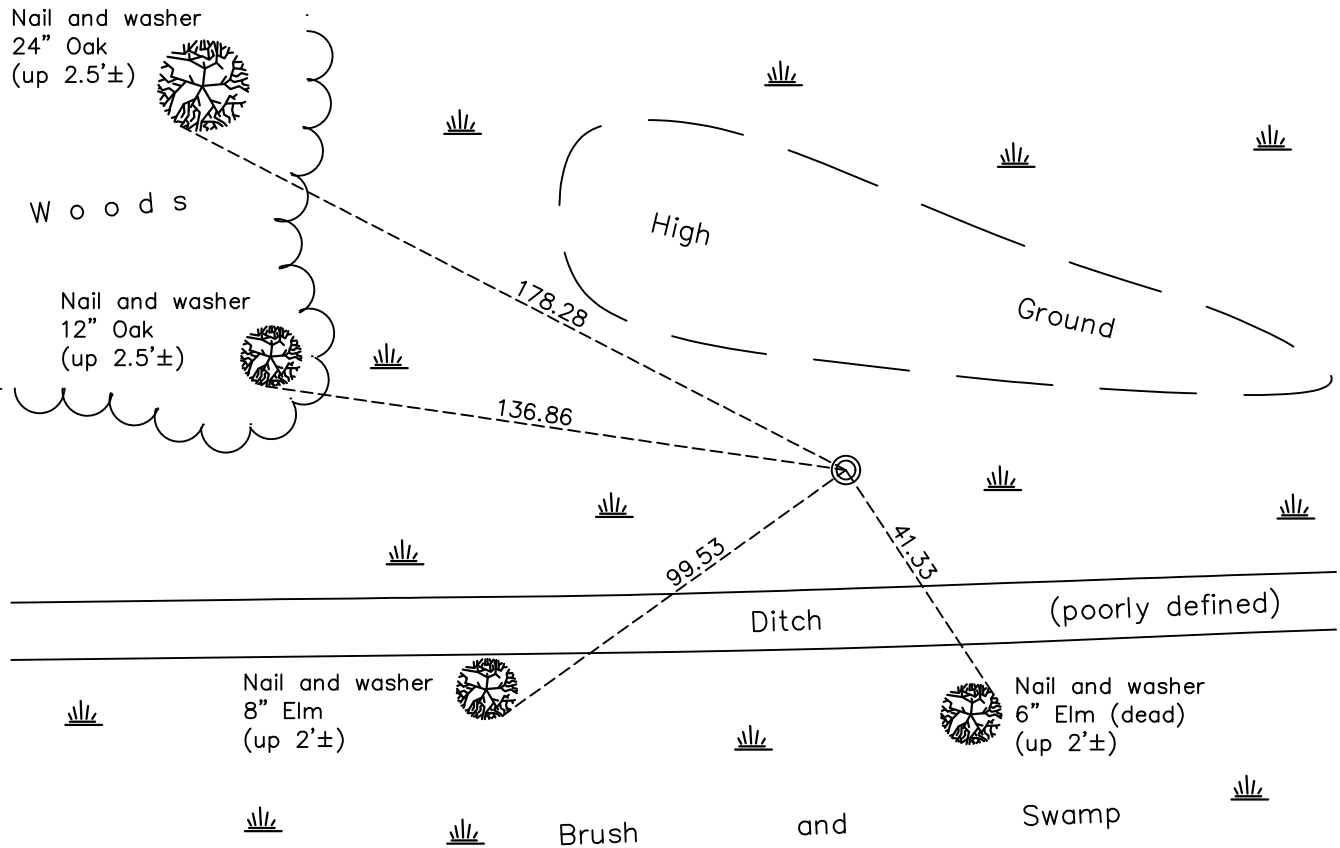

Revision Date  
3/30/2022

N.A.D. 1983 Coordinates  
 (1996 Adjustment)

| County Project Coordinates |                    |
|----------------------------|--------------------|
| Northing                   | <u>211625.4025</u> |
| Easting                    | <u>518295.5761</u> |
| Date                       | <u>3/18/03</u>     |

I hereby certify that this United States public land survey monument record is correct and complete to the best of my knowledge and belief.

*David Zieglmeier* Date 1/20/23

David Zieglmeier Anoka County Surveyor  
 Minnesota License Number 46179

# HISTORY OF GOVERNMENT CORNER

Page No. 60

County of Anoka

State of Minnesota

South 1/4 Corner of Sec. 15 Township 33 Range 23

## **CORNER HISTORY:**

July 2, 1973 - Set red and white iron pipe using area resurvey and established ties to monument.

August 16, 1974 - Found red and white iron pipe and updated ties.

July 5, 1977 - Found red and white iron pipe and updated ties.

June 18, 1981 - Found red and white iron pipe and updated ties.

July 6, 1984 - Found red and white iron pipe and updated ties.

June 8, 1987 - Found red and white iron pipe and updated ties.

February 26, 1992 - Found red and white iron pipe and updated ties.

March 18, 2003 - Found red and white iron pipe, established NAD 1983 (1996 adj.) Anoka County project coordinates by static GPS methods and updated ties.

January 25, 2013 - Found red and white iron pipe up 3'± and updated ties.

March 3, 2022 - Found red and white iron pipe up 3'± and verified position by VRS GPS method. Updated ties.