

CERTIFICATE OF LOCATION OF GOVERNMENT CORNER

County of Anoka

State of Minnesota


Southeast Corner of Sec. 17 Township 33 Range 23

On the 17th day of February, 1964, the described corner was evidenced by a concrete monument with a 1 1/2" iron pipe up 3'± on the west side

and to perpetuate the location of said corner, at the exact location thereof, a permanent marker was placed consisting of the same concrete monument with a 1 1/2" iron pipe up 3'± on the west side of monument

AND on the 14th day of March, 2022, said permanent marker was found up 1.0'± and the ties were updated. A County sign and post is on the north side of monument.

Updated reference ties are as shown below.

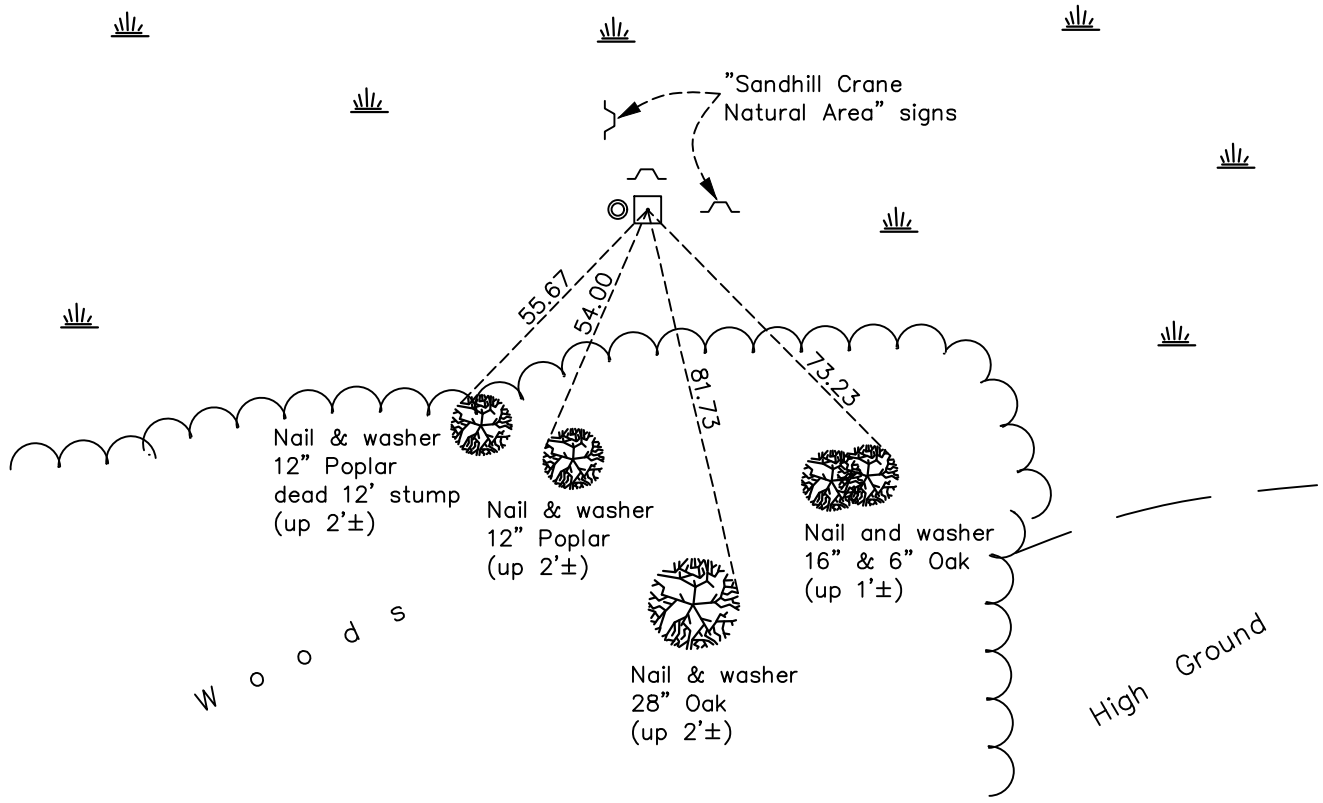

Revision Date
3/30/2022

N.A.D. 1983 Coordinates
(1996 Adjustment)

County Project Coordinates	
Northing	<u>211622.0926</u>
Easting	<u>510292.5030</u>
Date	<u>4/23/03</u>

I hereby certify that this United States public land survey monument record is correct and complete to the best of my knowledge and belief.

David Zieglmeier Date 2/1/23

David Zieglmeier Anoka County Surveyor
Minnesota License Number 46179

HISTORY OF GOVERNMENT CORNER

Page No. 64

County of Anoka

State of Minnesota

Southeast Corner of Sec. 17 Township 33 Range 23

CORNER HISTORY:

February 17, 1964 - Found concrete monument up 0.3' with a 1-1/2" iron pipe up 3' and 1'± west. Established ties to monument.

July 7, 1970 - Found concrete monument and updated ties.

August 6, 1974 - Found concrete monument and updated ties.

July 8, 1977 - Found concrete monument and updated ties.

April 2, 1987 - Found concrete monument and updated ties.

April 23, 2003 - Established NAD 1983 (1996 adj.) Anoka County project coordinates by static GPS methods.

February 12, 2013 - Found concrete monument up 0.5'±, verified position by VRS GPS methods and updated ties.

March 14, 2022 - Found concrete monument up 1.0'±, verified position by VRS GPS methods and updated ties.