

CERTIFICATE OF LOCATION OF GOVERNMENT CORNER

County of Anoka

State of Minnesota


West 1/4 Corner of Sec. 20 Township 33 Range 23

On the 5th day of June, 1944, the described corner was evidenced by a concrete monument

and to perpetuate the location of said corner, at the exact location thereof, a permanent marker was placed consisting of a partial cast iron monument set in concrete

AND on the 20th day of October, 2021, said permanent marker was found and the ties were updated

Updated reference ties are as shown below.

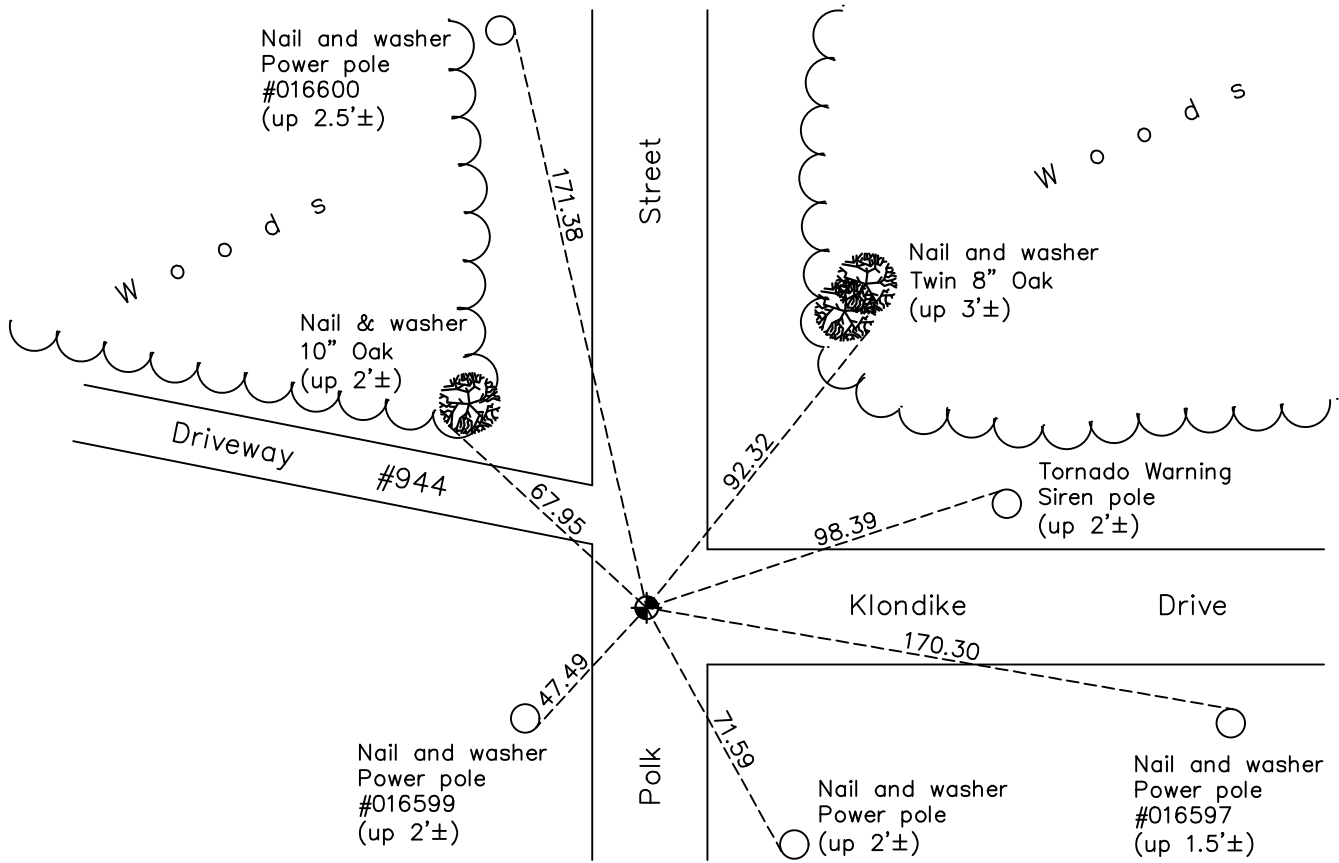

Revision Date

01/10/2022

N.A.D. 1983 Coordinates
(1996 Adjustment)

County Project Coordinates	
Northing	<u>209002.3017</u>
Easting	<u>505024.2165</u>
Date	<u>4/05/02</u>

I hereby certify that this United States public land survey monument record is correct and complete to the best of my knowledge and belief.

David Zieglmeier Date 2/1/23

David Zieglmeier Anoka County Surveyor
Minnesota License Number 46179

HISTORY OF GOVERNMENT CORNER

Page No. 69

County of Anoka

State of Minnesota

West 1/4 Corner of Sec. 20 Township 33 Range 23

CORNER HISTORY:

June 5, 1944 - Set concrete monument and established ties to monument.

July 23, 1962 - Found concrete monument with top broken off down 1'. Set 3/4" iron pipe on north side of monument and updated ties.

September 24, 1964 - Found concrete monument and updated ties.

June 23, 1970 - Found concrete monument with top broken off down 0.5'± and updated ties.

August 6, 1974 - Replaced broken concrete with a cast iron monument down 2.8'± and updated ties.

July 11, 1977 - Found cast iron monument and updated ties.

August 11, 1981 - Found cast iron monument and updated ties.

July 19, 1982 - Reset cast iron monument flush and updated ties.

June 14, 1984 - Found cast iron monument and updated ties.

July 29, 1992 - Found cast iron monument and updated ties.

July 30, 1997 - Found cast iron monument and updated ties.

May 16, 2000 - Found cast iron monument and updated ties.

April 5, 2002 - Established NAD 1983 (1996 adj.) Anoka County project coordinates by static GPS methods.

May 12, 2003 - Found cast iron monument, set construction ties, updated corner ties and removed monument prior to road construction.

August 27, 2003 - Set partial cast iron monument in concrete after road construction and updated ties.

February 20, 2013 - Found cast iron monument. Verified position by VRS GPS methods. Updated ties.

April 23, 2018 - Found cast iron monument. Verified position by VRS GPS methods. Updated ties.

October 20, 2021 - Found cast iron monument. Verified position by VRS GPS methods. Updated ties.