

CERTIFICATE OF LOCATION OF GOVERNMENT CORNER

County of Anoka

State of Minnesota


North 1/4 Corner of Sec. 27 Township 33 Range 23

On the 3rd day of April, 1969, the described corner was evidenced by area resurvey

and to perpetuate the location of said corner, at the exact location thereof, a permanent marker was placed consisting of a cast iron monument

AND on the 19th day of October, 2021, said permanent marker was Found flush and the
ties were updated

Updated reference ties are as shown below.

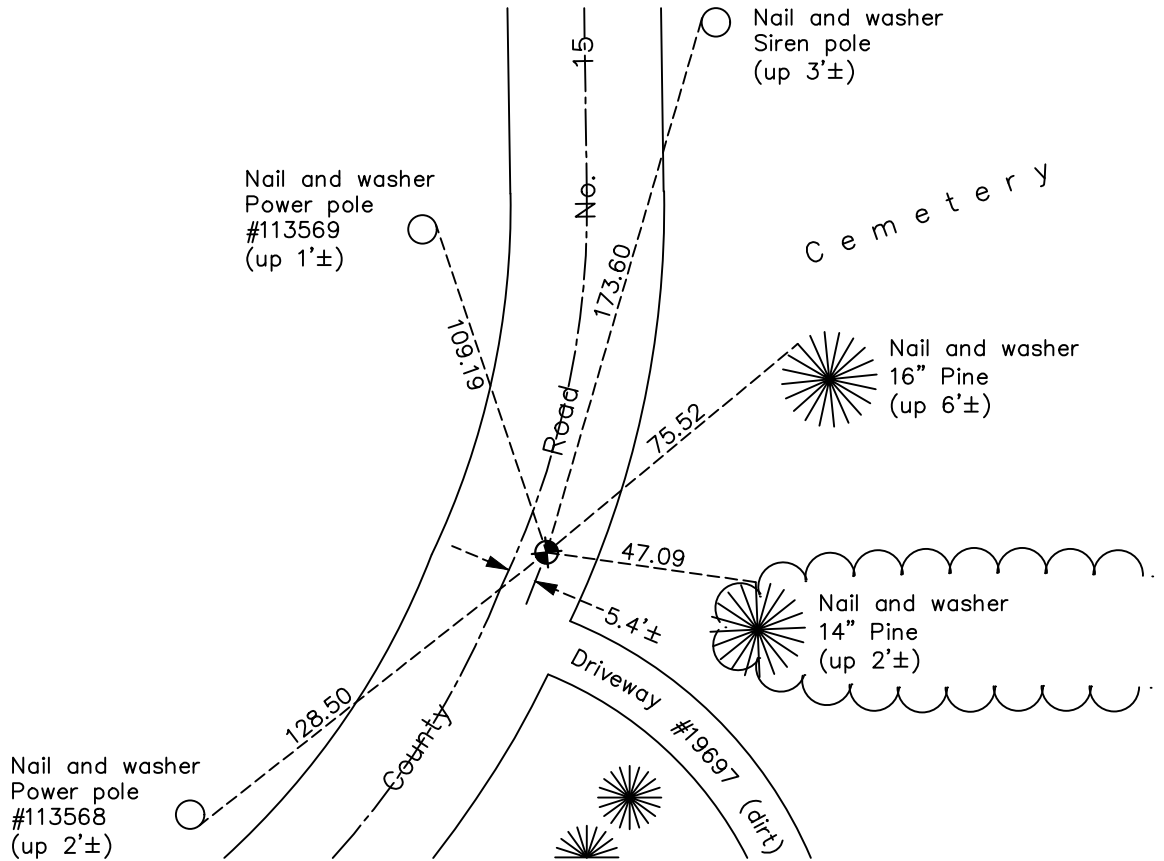

Revision Date
01/19/2022

N.A.D. 1983 Coordinates
(1996 Adjustment)

County Project Coordinates	
Northing	<u>206303.0854</u>
Easting	<u>518368.3943</u>
Date	<u>6/11/02</u>

I hereby certify that this United States public land survey monument record is correct and complete to the best of my knowledge and belief.

David Zieglmeier Date 2/1/23

David Zieglmeier Anoka County Surveyor
Minnesota License Number 46179

HISTORY OF GOVERNMENT CORNER

Page No. 81

County of Anoka

State of Minnesota

North 1/4 Corner of Sec. 27 Township 33 Range 23

CORNER HISTORY:

April 3, 1969 - Set cast iron monument flush using area resurvey and established ties to monument.

August 13, 1974 - Found cast iron monument and updated ties.

July 13, 1977 - Found cast iron monument and updated ties.

June 11, 1981 - Found cast iron monument and updated ties.

June 18, 1984 - Found cast iron monument and updated ties.

August 10, 1992 - Found cast iron monument and updated ties.

July 30, 1997 - Found cast iron monument and updated ties.

August 3, 2000 - Found cast iron monument and updated ties.

June 11, 2002 - Found cast iron monument and updated ties. Established NAD 1983 (1996 adj.) Anoka County project coordinates by static GPS methods.

January 30, 2013 - Found cast iron monument. Verified position by VRS GPS methods. Updated ties.

May 10, 2017 - Found cast iron monument, set construction ties, updated corner ties and verified position by VRS GPS methods prior to road construction.

May 11, 2017 - Removed cast iron monument

June 26, 2017 - Set cast iron monument and updated ties after road construction.

May 23, 2018 - Found cast iron monument flush. Verified position by VRS GPS methods. Updated ties.

October 19, 2021 - Found cast iron monument flush. Verified position by VRS GPS methods. Updated ties.