

# CERTIFICATE OF LOCATION OF GOVERNMENT CORNER

County of Anoka

State of Minnesota


## North 1/4 Corner of Sec. 5 Township 33 Range 23

On the 14th day of July, 1967, the described corner was evidenced by an iron pipe

and to perpetuate the location of said corner, at the exact location thereof, a permanent marker was placed consisting of a cast iron monument

AND on the 1st day of October, 2021, said permanent marker was found flush and the ties were updated

Updated reference ties are as shown below.

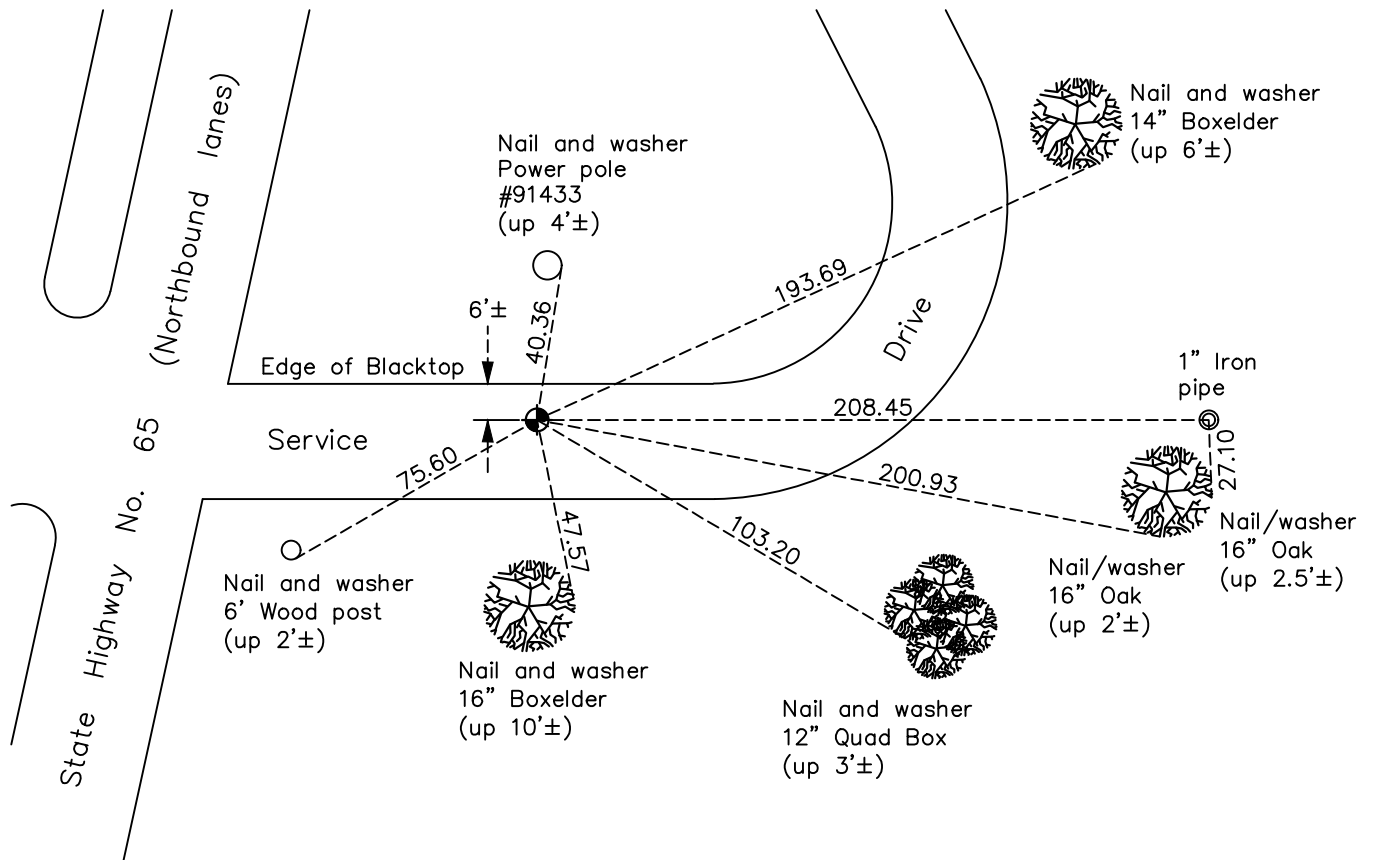

Revision Date  
01/21/2022

N.A.D. 1983 Coordinates  
(1996 Adjustment)

County Project Coordinates	
Northing	<u>227442.5257</u>
Easting	<u>508335.8710</u>
Date	<u>5/20/02</u>

I hereby certify that this United States public land survey monument record is correct and complete to the best of my knowledge and belief.

*David Zieglmeier* Date 2/1/23

David Zieglmeier Anoka County Surveyor  
Minnesota License Number 46179

# HISTORY OF GOVERNMENT CORNER

Page No. 119

County of Anoka

State of Minnesota

North 1/4 Corner of Sec. 5 Township 33 Range 23

## **CORNER HISTORY:**

February 19, 1959 - Bill Radicheak found a monument (unspecified type) and updated ties to monument.

July 14, 1967 - Found iron pipe and replaced with a cast iron monument. Updated ties to monument.

August 12, 1986 - Found cast iron monument and updated ties.

August 26, 1992 - Found cast iron monument and updated ties.

August 3, 2000 - Found cast iron monument and updated ties.

May 20, 2002 - Found cast iron monument and updated ties. Established NAD 1983 (1996 adj.) Anoka County project coordinates by static GPS methods.

January 18, 2013 - Found cast iron monument. Verified position by VRS GPS methods. Updated ties.

April 10, 2018 - Found cast iron monument flush. Verified position by VRS GPS methods. Updated ties.

October 1, 2021 - Found cast iron monument flush. Verified position by VRS GPS methods. Updated ties.