

CERTIFICATE OF LOCATION OF GOVERNMENT CORNER

County of Anoka

State of Minnesota


North 1/4 Corner of Sec. 25 Township 34 Range 23

On the 20th day of July, 1966, the described corner was evidenced by a 1/2" iron pipe found by N.C. Hoium and Associates

and to perpetuate the location of said corner, at the exact location thereof, a permanent marker was placed consisting of an Isanti County cast iron monument with a sign and post on the southeast side facing north

AND on the 9th day of November, 2021, said permanent marker was found up 0.3'± and the ties were updated

Updated reference ties are as shown below.

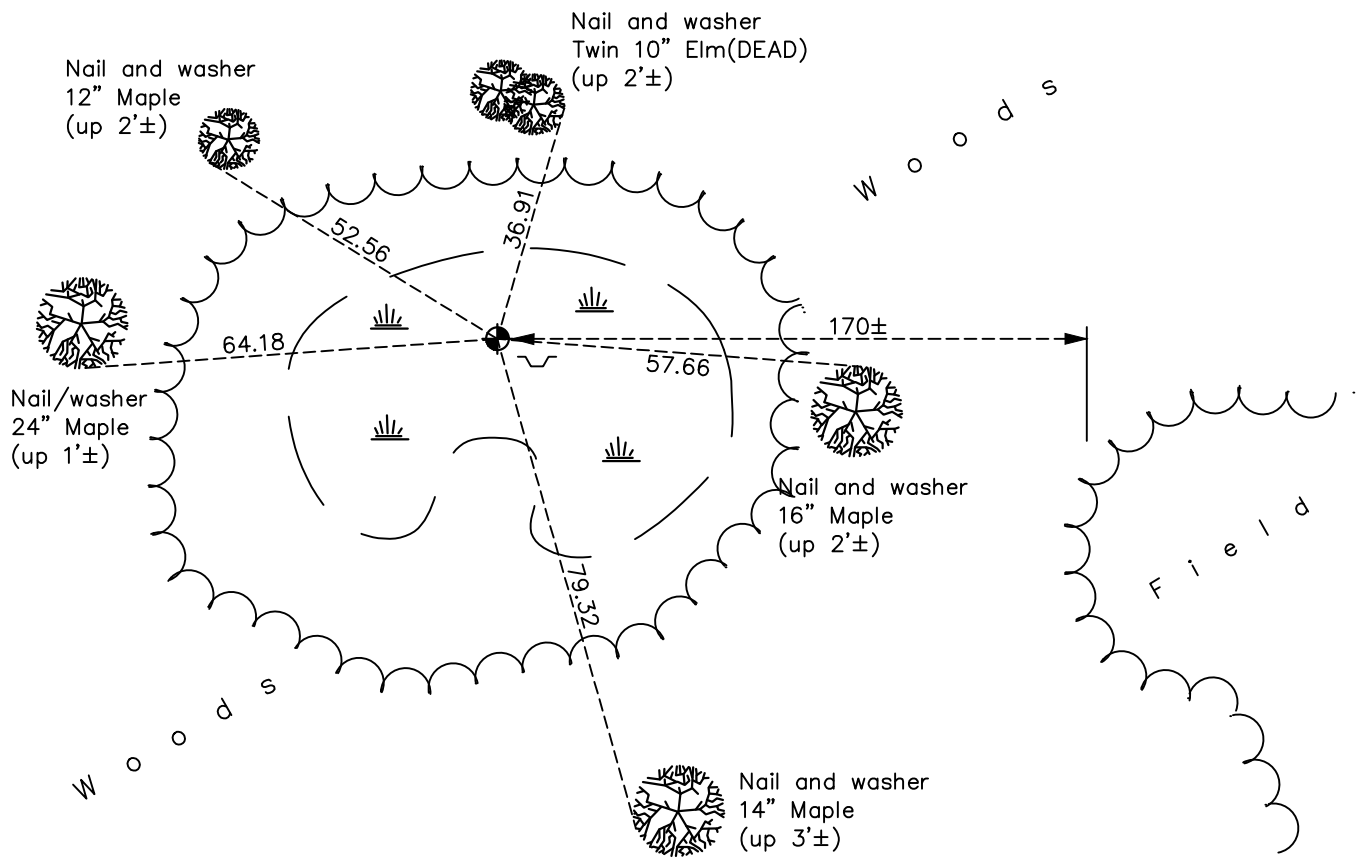

Revision Date
 01/07/2022

N.A.D. 1983 Coordinates
 (1996 Adjustment)

County Project Coordinates	
Northing	<u>238118.8562</u>
Easting	<u>529313.8738</u>
Date	<u>4/07/03</u>

I hereby certify that this United States public land survey monument record is correct and complete to the best of my knowledge and belief.

David Zieglsmeier Date 2/2/23

David M. Zieglsmeier, Anoka County Surveyor
 Minnesota License Number 46179

HISTORY OF GOVERNMENT CORNER

Page No. 52

County of Anoka

State of Minnesota

North 1/4 Corner of Sec. 25 Township 34 Range 23

CORNER HISTORY:

July 20, 1966 - Found 1/2" iron pipe up 0.4'±, set cast iron monument by N.C. Hoium and Associates, Inc. and established ties to monument.

October, 1968 - Found cast iron monument under water.

December 13, 1976 - Found cast iron monument and updated ties.

June 15, 1982 - Found cast iron monument and updated ties.

April 7, 2003 - Established NAD 1983 (1996 adj.) Anoka County project coordinates by static GPS methods.

April 26, 2012 - Found Isanti County cast iron monument up 0.3'±, verified position by VRS GPS methods and updated ties.

November 9, 2021 - Found Isanti County cast iron monument up 0.3'±, verified position by VRS GPS methods and updated ties.