

CERTIFICATE OF LOCATION OF GOVERNMENT CORNER

County of Anoka

State of Minnesota


Northwest Corner of Sec. 27 Township 34 Range 23

On the 6th day of December, 1976, the described corner was evidenced by area resurvey

and to perpetuate the location of said corner, at the exact location thereof, a permanent marker was placed consisting of a red and white iron pipe with a sign attached (facing northwest)

AND on the 3rd day of December, 2021, said permanent marker was found and the ties were updated

Updated reference ties are as shown below.

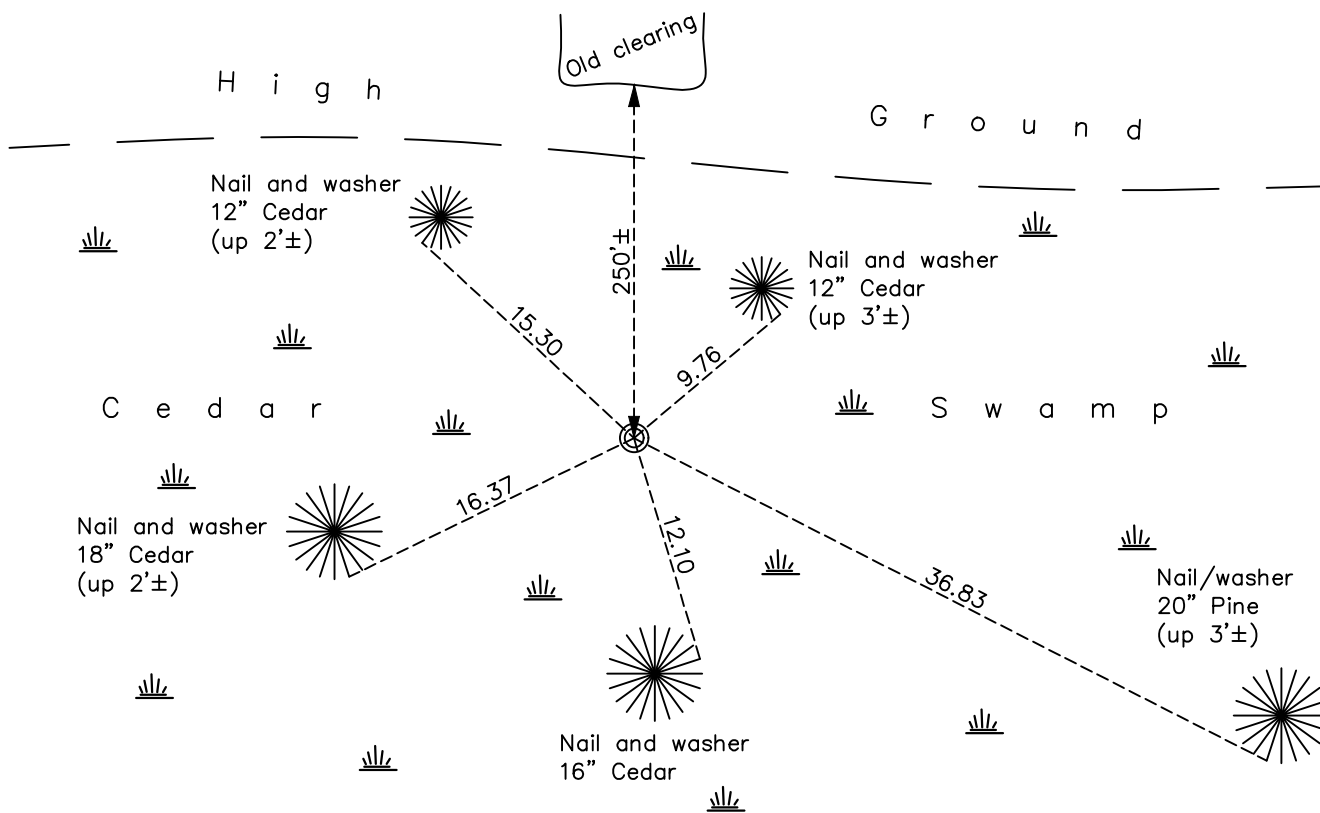

Revision Date
 01/07/2022

N.A.D. 1983 Coordinates
 (1996 Adjustment)

County Project Coordinates	
Northing	238214.5803
Easting	516036.9624
Date	4/14/03

I hereby certify that this United States public land survey monument record is correct and complete to the best of my knowledge and belief.

David Zieglmeier Date 2/2/23

David M. Zieglmeier, Anoka County Surveyor
 Minnesota License Number 46179

HISTORY OF GOVERNMENT CORNER

Page No. 57

County of Anoka

State of Minnesota

Northwest Corner of Sec. 27 Township 34 Range 23

CORNER HISTORY:

December 6, 1976 - Set red and white iron pipe up 3'± using area resurvey and established ties to monument.

August 15, 1978 - Found red and white iron pipe and updated ties.

March 31, 1988 - Found red and white iron pipe and updated ties.

September 11, 1992 - Found red and white iron pipe and updated ties.

April 14, 2003 - Established NAD 1983 (1996 adj.) Anoka County project coordinates by static GPS methods.

December 27, 2012 - Found red and white iron pipe and updated ties.

December 3, 2021 - Found red and white iron pipe and updated ties.