

CERTIFICATE OF LOCATION OF GOVERNMENT CORNER

County of Anoka

State of Minnesota


West 1/4 Corner of Sec. 30 Township 34 Range 23

On the 19th day of August, 1974, the described corner was evidenced by area resurvey

and to perpetuate the location of said corner, at the exact location thereof, a permanent marker was placed consisting of a cast iron monument (down 1'±) with a sign and post on the east side

AND on the 2nd day of November, 2021, said permanent marker was found down 1'± and the ties were updated

Updated reference ties are as shown below.

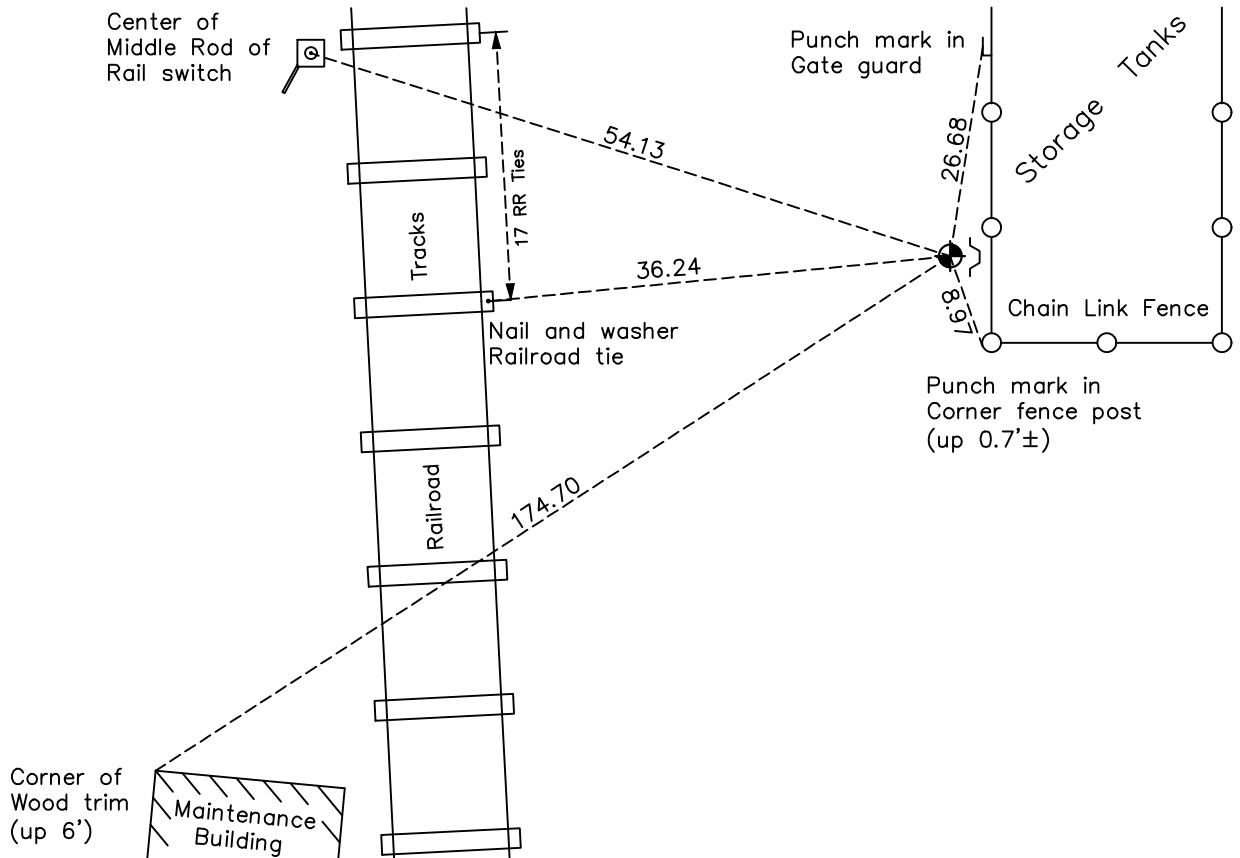

Revision Date
 01/10/2022

N.A.D. 1983 Coordinates
 (1996 Adjustment)

County Project Coordinates	
Northing	<u>235392.0028</u>
Easting	<u>500334.3942</u>
Date	<u>5/15/02</u>

I hereby certify that this United States public land survey monument record is correct and complete to the best of my knowledge and belief.

David Zieglermeier Date 2/2/23

David M. Zieglermeier, Anoka County Surveyor
 Minnesota License Number 46179

HISTORY OF GOVERNMENT CORNER

Page No. 64

County of Anoka

State of Minnesota

West 1/4 Corner of Sec. 30 Township 34 Range 23

CORNER HISTORY:

August 19, 1974 - Set cast iron monument using area resurvey and established ties to monument.

August 11, 1975 - Found cast iron monument and updated ties.

August 16, 1978 - Found cast iron monument and updated ties.

May 28, 1982 - Found cast iron monument and updated ties.

August 4, 1986 - Found cast iron monument and updated ties.

June 10, 1988 - Reset corner position after construction using area resurvey and remaining corner tie. updated ties.

July 22, 1988 - Set cast iron monument down 1'±.

August 5, 1992 - Found cast iron monument and updated ties.

August 6, 1997 - Found cast iron monument and updated ties.

September 18, 1998 - Found cast iron monument down 1'± and updated ties.

May 25, 2000 - Found cast iron monument and updated ties.

May 15, 2002 - Found cast iron monument and updated ties. Established NAD 1983 (1996 adj.) Anoka County project coordinates by static GPS methods.

December 6, 2012 - Found cast iron monument down 1'±. Verified position by VRS GPS methods. Updated ties.

April 6, 2018 - Found cast iron monument down 1'±. Verified position by VRS GPS methods. Updated ties.

November 2, 2021 - Found cast iron monument down 1'±. Verified position by VRS GPS methods. Updated ties.