

CERTIFICATE OF LOCATION OF GOVERNMENT CORNER

County of Anoka

State of Minnesota

East $\frac{1}{4}$ Corner of Sec. 29 Township 34 Range 23



On the 10th day of April, 2013, the described corner was evidenced by a cast iron monument set on top of cast iron monument below

and to perpetuate the location of said corner, at the exact location thereof, a permanent marker was placed consisting of a new cast iron monument

AND on the 12th day of December, 2025, said permanent marker was found down 0.2'±.

Verified position with RTK GPS. Updated ties.

Updated reference ties are as shown below.

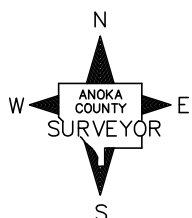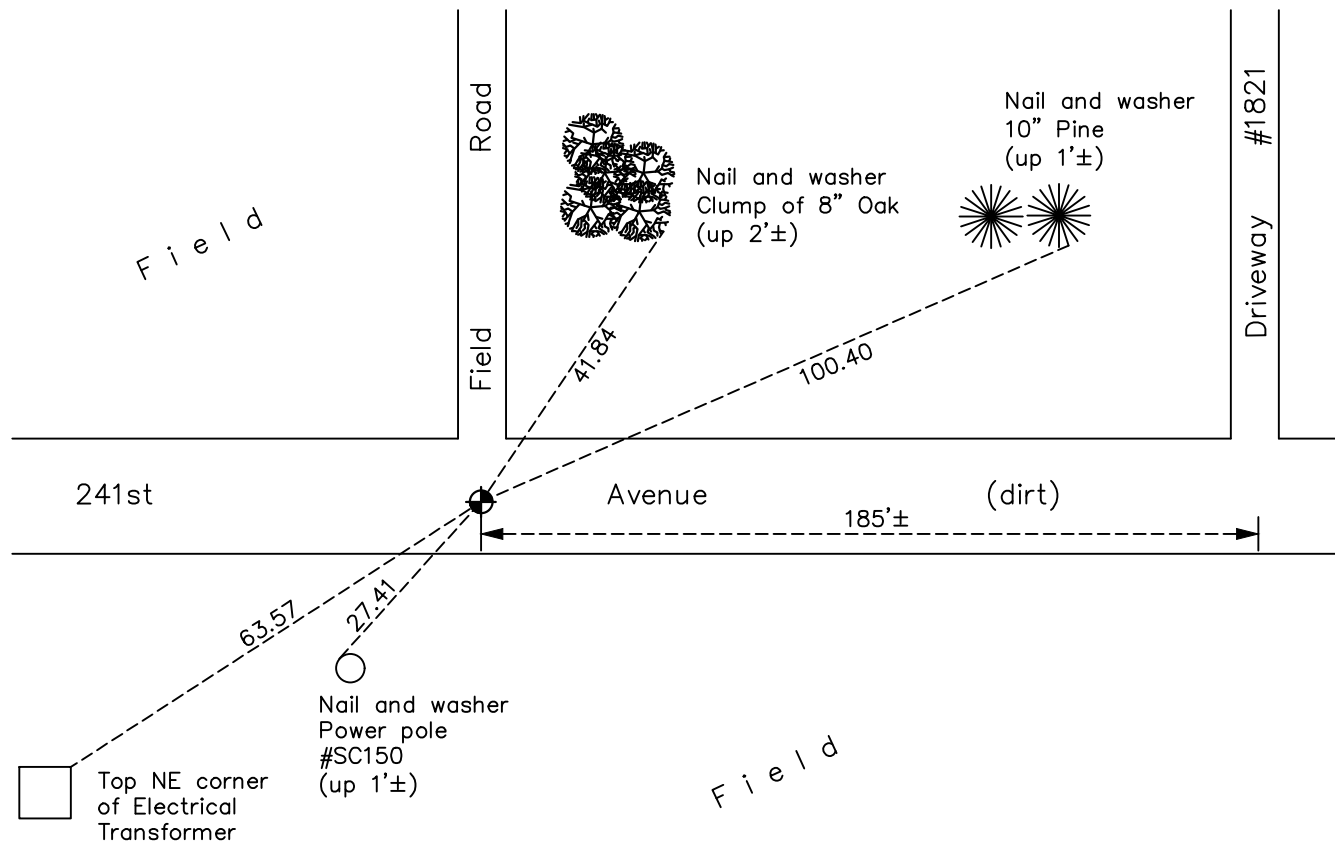

Revision Date

02/20/2026

N.A.D. 1983 Coordinates
(1996 Adjustment)

County Project Coordinates

Northing 235399.2289

Easting 510800.5155

Date 5/15/02

I hereby certify that this United States public land survey monument record is correct and complete to the best of my knowledge and belief.

David Zieglmeier Date 6/3/26

David M. Zieglmeier, Anoka County Surveyor

Minnesota License Number 46179

HISTORY OF GOVERNMENT CORNER

Page No. 66

County of Anoka

State of Minnesota

East 1/4 Corner of Sec. 29 Township 34 Range 23

CORNER HISTORY:

November 1854 - This corner was established by Hiram Taylor, Deputy Surveyor. Taylor marked this position by "set quarter section post" with two bearing trees marked as accessories.

December 8, 1976 - Set cast iron monument down 0.5'± using area resurvey. Established ties.

April 12, 1978 - Reset cast iron monument to new location and down 1'±. Updated ties.

8/18/78, 5/26/82, 8/6/86, 8/5/92, 8/7/97 - Found cast iron monument. Updated ties.

May 15, 2002 - Found cast iron monument down 2'±. Established NAD 1983 (1996 adj.) Anoka County project coordinates by static GPS methods. Updated ties.

N = 235399.2289

E = 510800.5155

October 29, 2012 - Found cast iron monument down 2'±. Updated ties.

April 10, 2013 - Set full cast iron monument (down 0.5'±) on top of full cast iron monument below.

6/18/18, 11/4/21 - Found cast iron monument down 0.2'±. Verified position by VRS GPS methods. Updated ties.

December 12, 2025 - Found cast iron monument down 0.2'±. Verified position with RTK GPS. Updated ties.