

# CERTIFICATE OF LOCATION OF GOVERNMENT CORNER

County of Anoka

State of Minnesota



Witness Corner of Sec. 25 Township 34 Range 23  
(on west line of NW 1/4)

On the 5th day of October, 1978, the described corner was evidenced by a 1/2" iron pipe set by N.C. Hoium

and to perpetuate the location of said corner, at the exact location thereof, a permanent marker was placed consisting of a cast iron monument

AND on the 22nd day of May, 2023, said permanent marker was reset cast iron monument, set flush, after road construction using ACS RTK GPS method. Verified w/ historic ties & updated.

Updated reference ties are as shown below.

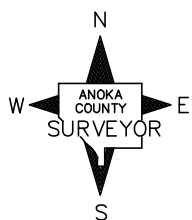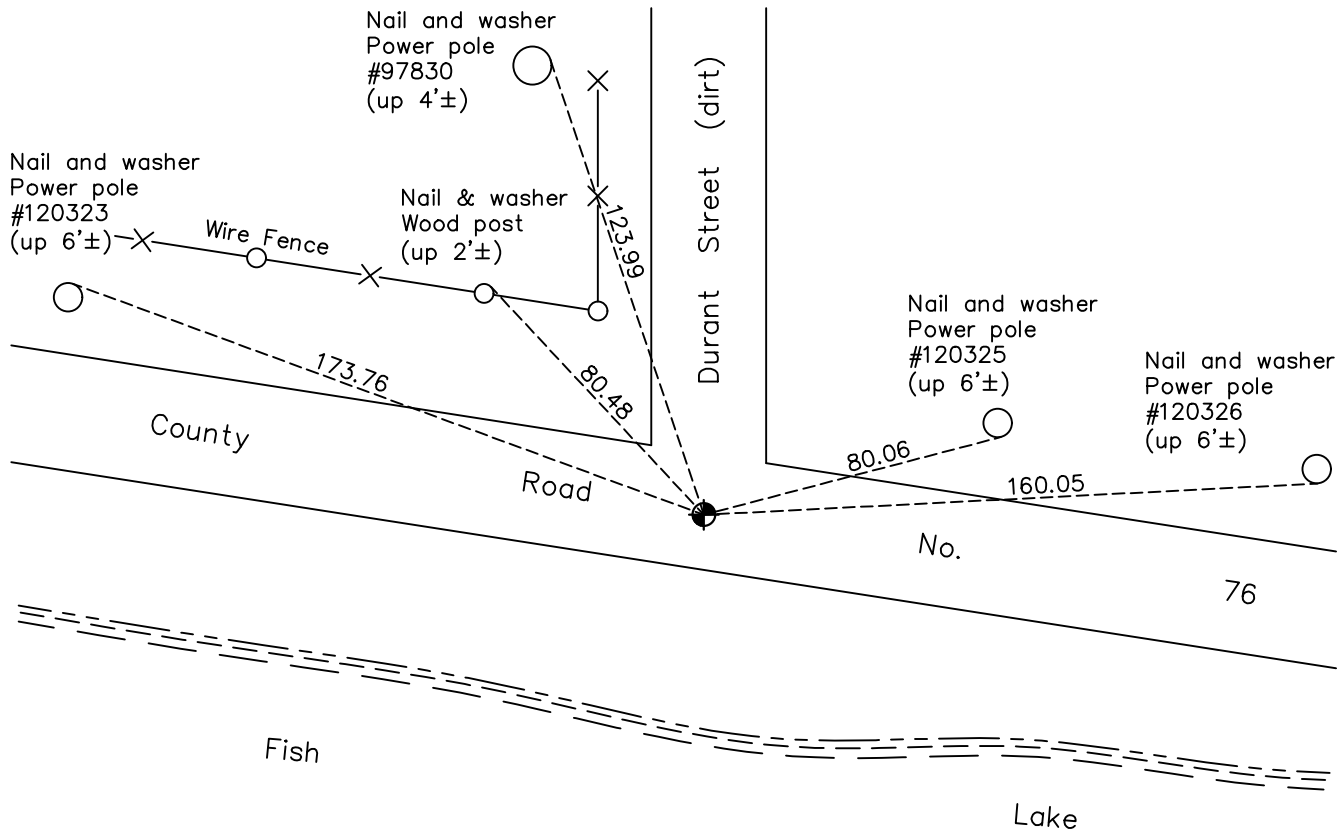

Revision Date  
5/31/2023

N.A.D. 1983 Coordinates  
 (1996 Adjustment)

County Project Coordinates	
Northing	<u>236194.0251</u>
Easting	<u>526654.5239</u>
Date	<u>5/22/02</u>

I hereby certify that this United States public land survey monument record is correct and complete to the best of my knowledge and belief.

*David Zieglsmeier* Date 12/11/23

David M. Zieglsmeier, Anoka County Surveyor  
 Minnesota License Number 46179

# HISTORY OF GOVERNMENT CORNER

Page No. 69A

County of Anoka

State of Minnesota

Witness Corner of Sec. 25 Township 34 Range 23  
(on west line of NW 1/4)

## **CORNER HISTORY:**

October 5, 1978 - Found 1/2" iron pipe set by N.C. Hoium, replaced with a cast iron monument flush and established ties to monument.

October 3, 1979 - Raised cast iron monument.

8/27/81, 8/1/86, 8/4/92, 8/4/97 - Found cast iron monument and updated ties.

May 22, 2002 - Established NAD 1983 (1996 adj.) Anoka County project coordinates by static GPS methods.

July 25, 2012 - Found cast iron monument down 0.2'± and raised flush. Verified position by VRS GPS methods. Updated ties.

4/2/18, 11/5/21 - Found cast iron monument flush. Verified position by VRS GPS methods. Updated ties.

May 22, 2023 - Reset cast iron monument, set flush, after road construction using ACS RTK GPS method. Verified position with historic ties and updated ties after setting. Job no 22-131