

CERTIFICATE OF LOCATION OF GOVERNMENT CORNER

County of Anoka

State of Minnesota


South 1/4 Corner of Sec. 27 Township 34 Range 23

On the 30th day of August, 1976, the described corner was evidenced by a 3/4" iron pipe

and to perpetuate the location of said corner, at the exact location thereof, a permanent marker was placed consisting of a red and white iron pipe with a sign attached facing West

AND on the 7th day of March, 2022, said permanent marker was found up 2'± with the paint worn off and the ties were updated.

Updated reference ties are as shown below.

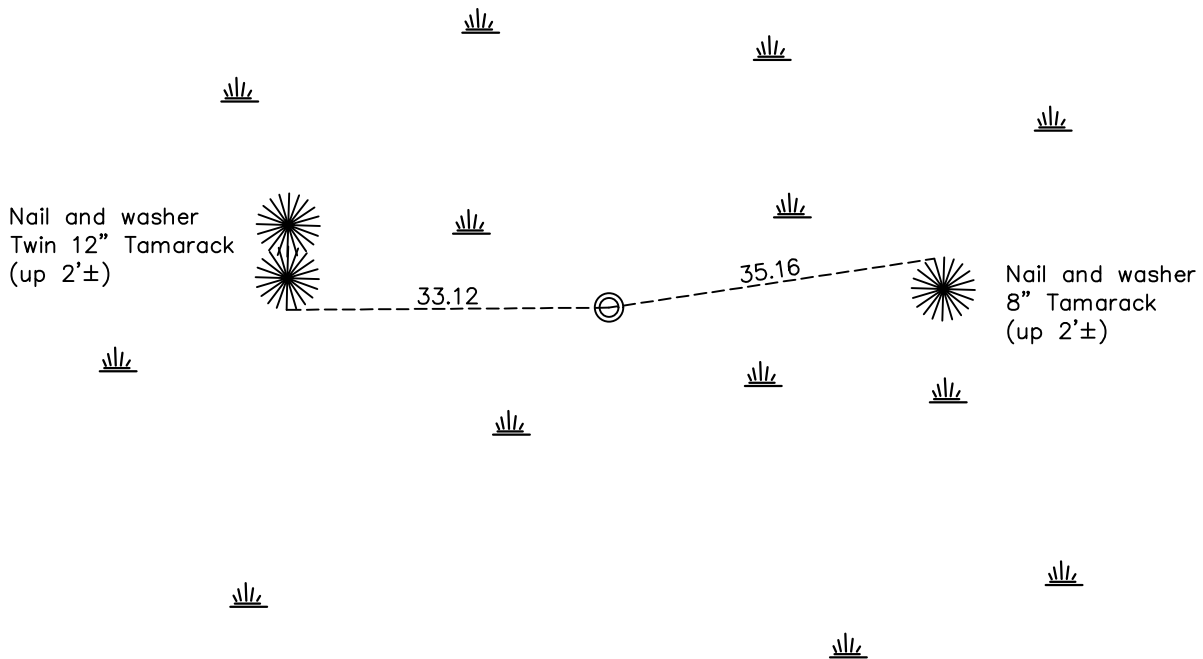

Revision Date

3/30/2022

N.A.D. 1983 Coordinates
(1996 Adjustment)

County Project Coordinates	
Northing	<u>232887.2107</u>
Easting	<u>518781.3579</u>
Date	<u>4/07/03</u>

I hereby certify that this United States public land survey monument record is correct and complete to the best of my knowledge and belief.

David Zieglmeier Date 2/8/23

David Zieglmeier Anoka County Surveyor
Minnesota License Number 46179

HISTORY OF GOVERNMENT CORNER

Page No. 77

County of Anoka

State of Minnesota

South 1/4 Corner of Sec. 27 Township 34 Range 23

CORNER HISTORY:

August 30, 1976 - Found 3/4" iron pipe and replaced with red and white iron pipe. Established ties to iron pipe.

April 7, 2003 - Established NAD 1983 (1996 adj.) Anoka County project coordinates by static GPS methods.

October 26, 2012 - Found red and white iron pipe up 2'± w/sign. Verified position by VRS GPS methods.
Updated ties.

March 12, 2019 - Found red and white iron pipe up 2'±. Verified position by VRS GPS methods. Updated ties.

March 7th, 2022 - Found 2" iron pipe up 2'±. Verified position by VRS GPS method and updated ties.