

# CERTIFICATE OF LOCATION OF GOVERNMENT CORNER

County of Anoka

State of Minnesota


## Northwest Corner of Sec. 31 Township 34 Range 23

On the 14th day of July, 1967, the described corner was evidenced by a 1" iron bolt

and to perpetuate the location of said corner, at the exact location thereof, a permanent marker was placed consisting of a cast iron monument

AND on the 18th day of May, 2023, said permanent marker was set cast iron monument after road construction, verified using RTK GPS methods. Updated ties.

Updated reference ties are as shown below.

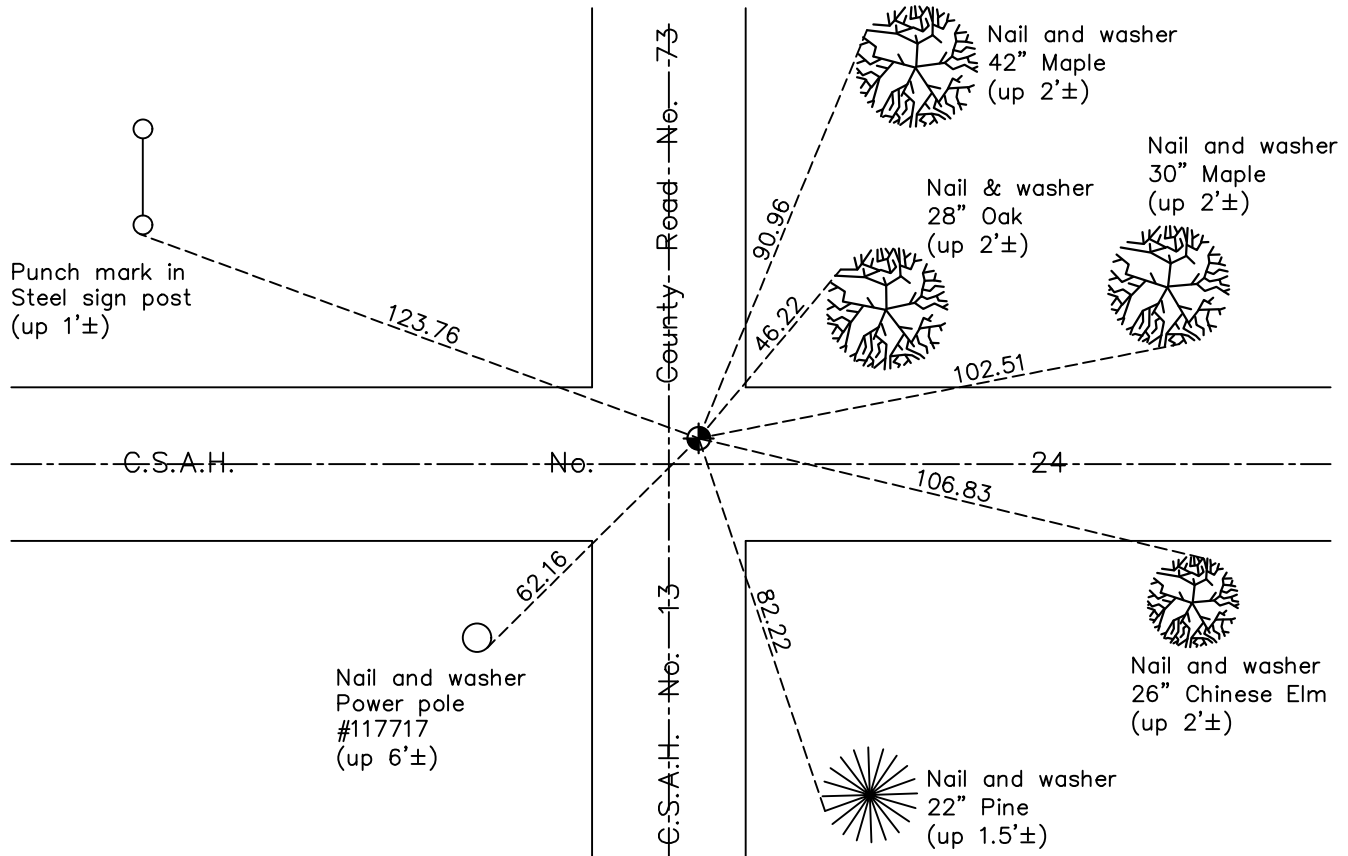

Revision Date  
5/31/2023

N.A.D. 1983 Coordinates  
(1996 Adjustment)

| County Project Coordinates |                    |
|----------------------------|--------------------|
| Northing                   | <u>232732.2258</u> |
| Easting                    | <u>500338.5341</u> |
| Date                       | <u>5/15/02</u>     |

I hereby certify that this United States public land survey monument record is correct and complete to the best of my knowledge and belief.

*David Zieglmeier* Date 6/28/23

David M. Zieglmeier, Anoka County Surveyor  
Minnesota License Number 46179

# HISTORY OF GOVERNMENT CORNER

Page No. 84

County of Anoka

State of Minnesota

## Northwest Corner of Sec. 31 Township 34 Range 23

### **CORNER HISTORY:**

Unknown date - Iron bolt with ties by N.C.Hoium.

February 23, 1962 - Found iron bolt flush and updated ties.

July 14, 1967 - Found iron bolt and replaced with cast iron monument flush. Updated ties.

8/17/71, 8/8/75 - Found cast iron monument and updated ties.

October 25, 1977 - Raised cast iron monument.

8/22/78, 5/27/82, 8/4/86, 8/5/92, 8/6/97, 5/25/00 - Found cast iron monument flush and updated ties.

May 15, 2002 - Found cast iron monument and updated ties. Established NAD 1983 (1996 adj.) Anoka County project coordinates by static GPS methods.

December 7, 2012 - Found cast iron monument and raised flush with the surface. Verified position by VRS GPS methods and updated ties.

May 14, 2013 - Found cast iron monument and updated ties due to nearby road construction. Monument not removed.

4/5/18, 11/4/21 - Found cast iron monument flush. Verified position by VRS GPS methods. Updated ties.

May 18, 2023 - set cast iron monument after road construction, verified position using RTK GPS methods. Updated ties. Job no. 22-131