

CERTIFICATE OF LOCATION OF GOVERNMENT CORNER

County of Anoka

State of Minnesota


West 1/4 Corner of Sec. 34 Township 34 Range 23

On the 24th day of August, 1976, the described corner was evidenced by a 3/4" iron pipe

and to perpetuate the location of said corner, at the exact location thereof, a permanent marker was placed consisting of a red and white iron pipe with sign attached facing south

AND on the 24th day of March, 2023, said permanent marker was removed to set a new 6' x 2" square steel Telspar set up 1'± w/ punched cap. No ties available.

Updated reference ties are as shown below.

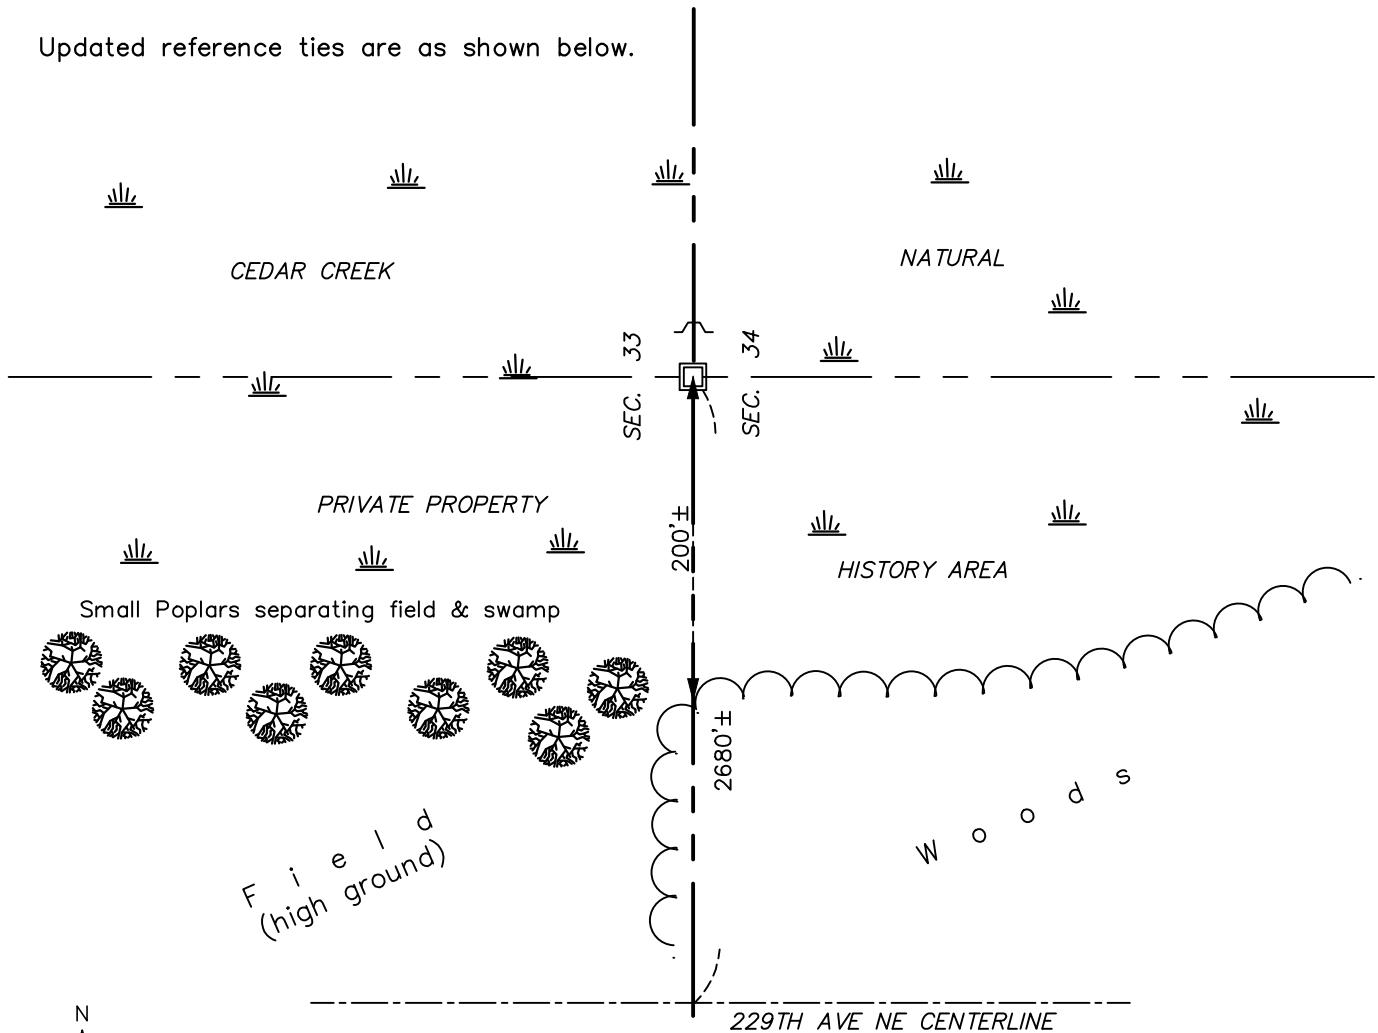

Revision Date

3/27/2023

N.A.D. 1983 Coordinates
(1996 Adjustment)

County Project Coordinates

Northing 230231.8091

Easting 516164.6764

Date 4/09/03

I hereby certify that this United States public land survey monument record is correct and complete to the best of my knowledge and belief.

David Zieglmeier Date 6/28/23

David Zieglmeier, Anoka County Surveyor

Minnesota License Number 46179

HISTORY OF GOVERNMENT CORNER

Page No. 88

County of Anoka

State of Minnesota

West 1/4 Corner of Sec. 34 Township 34 Range 23

CORNER HISTORY:

August 24, 1976 - Found 3/4" iron pipe and old rotted stake lying in swamp (set in 1908). Found dead 5" witness tree to North 10'±. Replaced 3/4" iron pipe with red and white iron pipe up 3'± and established ties.

May 6, 1996 - Found red and white iron pipe and updated ties.

October 26, 2012 - Found red and white iron pipe up 3'± and leaning west approximately 0.8'±. Verified position of base at ground level using VRS GPS methods. Updated ties.

December 6, 2021 - Found red and white iron pipe up 3'± and leaning west approximately 1'±. Verified position of base at ground level using VRS GPS methods. Updated ties.

March 8, 2023 - Removed found red & white iron pipe and replaced with Telspar set up 1'± and punchmarked cap using County RTK GPS. Added sign and post set, 1'± to North, facing South. No ties available.