

# CERTIFICATE OF LOCATION OF GOVERNMENT CORNER

County of Anoka

State of Minnesota



## North 1/4 Corner of Sec. 3 Township 30 Range 24

On the 12th day of June, 1969, the described corner was evidenced by a 3/4" iron pipe

and to perpetuate the location of said corner, at the exact location thereof, a permanent marker was placed consisting of a cast iron monument

AND on the 18th day of August, 2022, said permanent marker was found flush to the surface and the ties were updated.

Updated reference ties are as shown below.

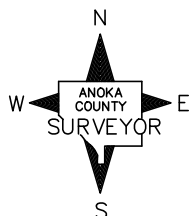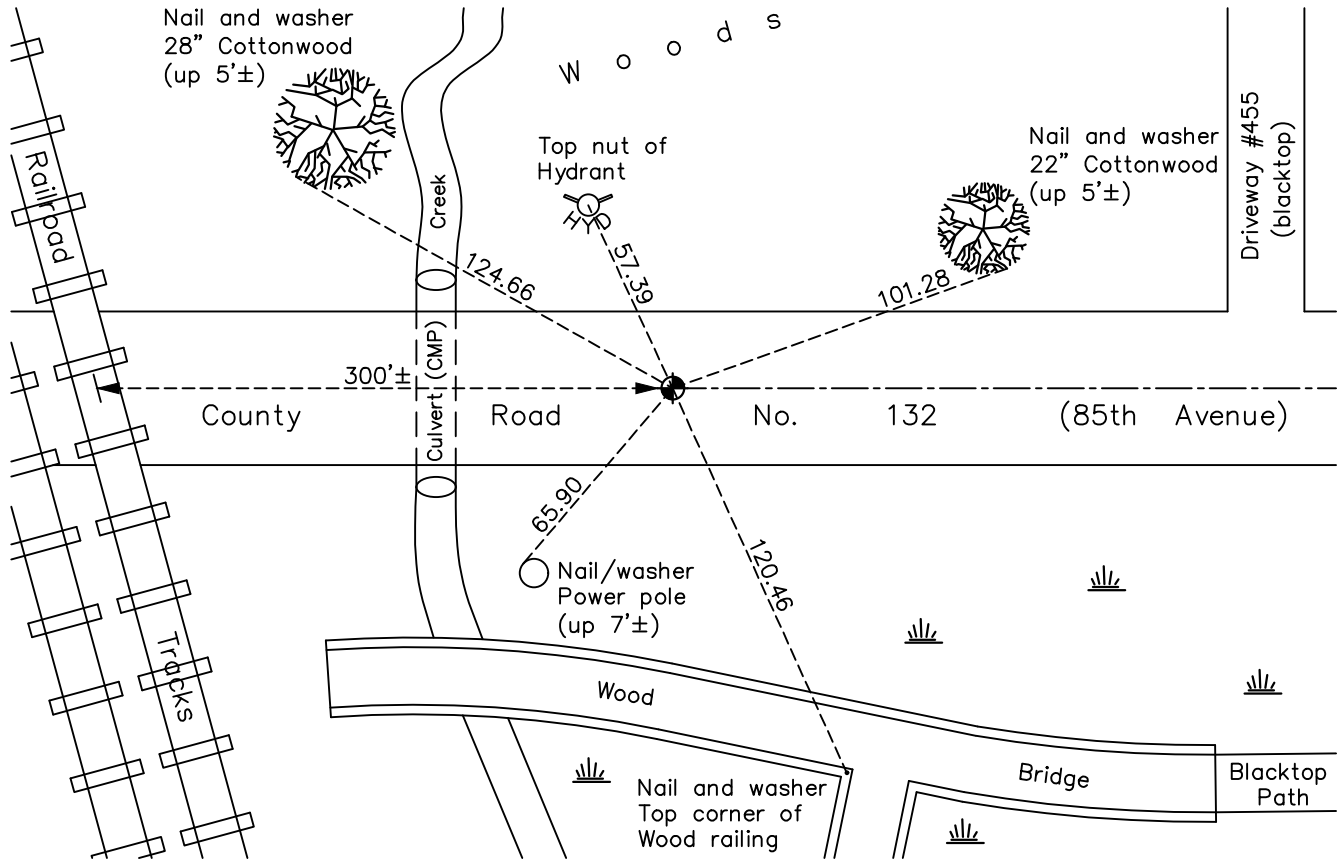

Revision Date  
12/21/22

N.A.D. 1983 Coordinates  
(1996 Adjustment)

County Project Coordinates	
Northing	<u>132510.2535</u>
Easting	<u>496785.9886</u>
Date	<u>12/15/04</u>

I hereby certify that this United States public land survey monument record is correct and complete to the best of my knowledge and belief.

*David Zieglmeier* Date 12/11/23

David Zieglmeier Anoka County Surveyor  
Minnesota License Number 46179

# HISTORY OF GOVERNMENT CORNER

Page No. 7

County of Anoka

State of Minnesota

## North 1/4 Corner of Sec. 3 Township 30 Range 24

### **CORNER HISTORY:**

March 20, 1963 - Found 3/4" pinched iron pipe flush and updated ties.

July 7, 1966 - Found 3/4" pinched iron pipe flush and updated ties.

June 10, 1968 - Found 3/4" pinched iron pipe missing and all corner ties gone.

June 12, 1969 - Set 3/4" iron pipe down 0.3'± in gravel road by N.C. Hoium. Updated ties.

August 20, 1969 - Found 3/4" iron pipe and replaced with a cast iron monument. Updated ties.

June 15, 1970 - Found cast iron monument broken off. Set new cast iron monument flush with blacktop road. Updated ties.

May 10, 1973 - Found cast iron monument and updated ties.

June 24, 1973 - Found cast iron monument and updated ties.

August 16, 1976 - Found cast iron monument and updated ties.

July 28, 1977 - Found cast iron monument and updated ties.

October 12, 1981 - Found cast iron monument. Set construction ties and updated corner ties prior to road construction.

June 11, 1982 - Set cast iron monument flush after road construction and updated ties.

June 24, 1986 - Found cast iron monument and updated ties.

June 27, 1989 - Found cast iron monument and updated ties.

July 28, 1994 - Found cast iron monument and updated ties.

December 15, 2004 - Established NAD 1983 (1996 adj.) Anoka County project coordinates by static GPS methods.

August 18, 2008 - Found cast iron monument and updated ties.

November 24, 2014 - Found cast iron monument down 0.3'± and raised flush. Verified position by VRS GPS methods. Updated ties.

May 16, 2017 - Found cast iron monument. Verified position by VRS GPS methods. Set construction ties and updated corner ties prior to road construction. Removed monument.

August 18, 2017 - Set cast iron monument after road construction using static GPS methods. Updated ties.

November 19, 2019 - Found cast iron monument. Verified position by VRS GPS methods. Updated ties.

August 18, 2022 - Found cast iron monument. Verified position by VRS GPS methods. Updated ties.