

CERTIFICATE OF LOCATION OF GOVERNMENT CORNER

County of Anoka

State of Minnesota


East 1/4 Corner of Sec. 13 Township 30 Range 24

On the 19th day of September, 1961, the described corner was evidenced by a granite monument

and to perpetuate the location of said corner, at the exact location thereof, a permanent marker was placed consisting of a cast iron monument

AND on the 5th day of August, 2022, said permanent marker was found flush and the ties were updated

Updated reference ties are as shown below.

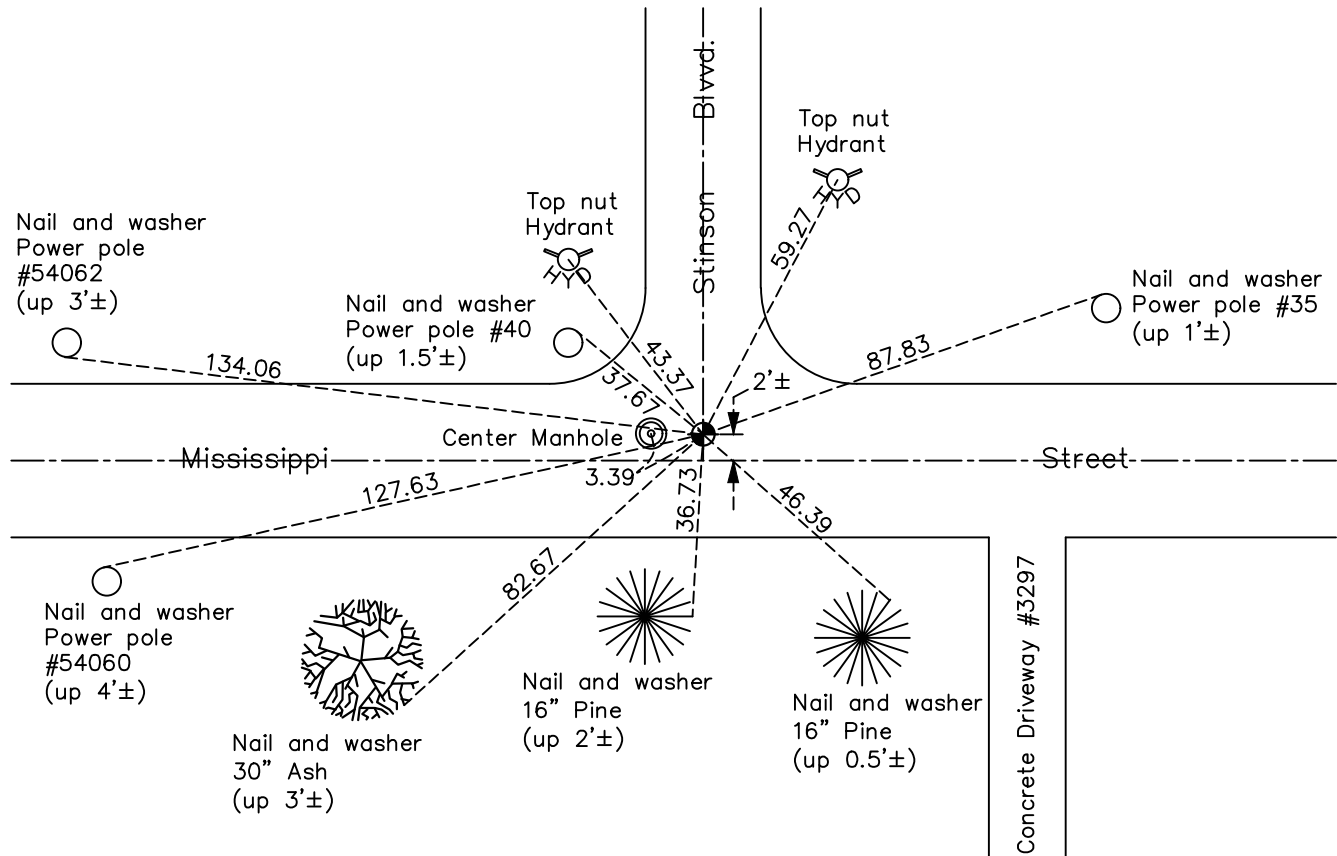

Revision Date
12/22/22

N.A.D. 1983 Coordinates
(1996 Adjustment)

County Project Coordinates	
Northing	<u>118469.2442</u>
Easting	<u>510077.1391</u>
Date	<u>7/21/04</u>

I hereby certify that this United States public land survey monument record is correct and complete to the best of my knowledge and belief.

David Zieglmeier Date 12/11/23

David Zieglmeier Anoka County Surveyor
Minnesota License Number 46179

HISTORY OF GOVERNMENT CORNER

Page No. 36

County of Anoka

State of Minnesota

East 1/4 Corner of Sec. 13 Township 30 Range 24

CORNER HISTORY:

- March 30, 1943 - Harvey Cartwright found a 8" x 8" granite monument flush and updated the ties.
- June 22, 1960 - Found granite monument down 2" with an iron on the South side. Updated ties.
- September 19, 1961 - Found granite monument missing with a P.K. nail in place. Checked ties.
- July 24, 1964 - Found cast iron monument with 'Quarter Corner' printed on it. Updated ties.
- July 1, 1966 - Found cast iron monument with 'Quarter Corner' printed on it. Updated ties.
- August 19, 1968 - Found cast iron monument with 'Quarter Corner' printed on it and replaced it with a Anoka County cast iron monument flush. Updated ties.
- August 18, 1970 - Found cast iron monument and updated ties.
- June 24, 1974 - Found cast iron monument and updated ties.
- August 1, 1977 - Found cast iron monument and updated ties.
- July 18, 1980 - Found cast iron monument and updated ties.
- July 18, 1989 - Found cast iron monument and updated ties.
- July 28, 1994 - Found cast iron monument and updated ties.
- June 20, 2001 - Found cast iron monument and set construction ties prior to construction. Removed monument.
- July 21, 2004 - Established NAD 1983 (1996 adj.) Anoka County project coordinates by static GPS methods.
- August 11, 2004 - Found cast iron monument and updated ties.
- September 4, 2008 - Found cast iron monument and updated ties.
- October 29, 2014 - Found cast iron monument and updated ties.
- December 3, 2019 - Found cast iron monument. Verified position by VRS GPS methods. Updated ties.
- August 5, 2022 - Found cast iron monument flush. Verified position by VRS GPS methods. Updated ties.