

CERTIFICATE OF LOCATION OF GOVERNMENT CORNER

County of Anoka

State of Minnesota



Meander Corner of Sec. 14 Township 30 Range 24
(on east line of section)

On the 2nd day of September, 1960, the described corner was evidenced by a concrete
monument

and to perpetuate the location of said corner, at the exact location thereof, a permanent marker
was placed consisting of a cast iron monument

AND on the ____ day of October, 2014, said permanent marker was found down 0.1'± and
the ties were updated

Updated reference ties are as shown below.

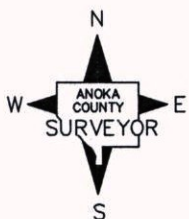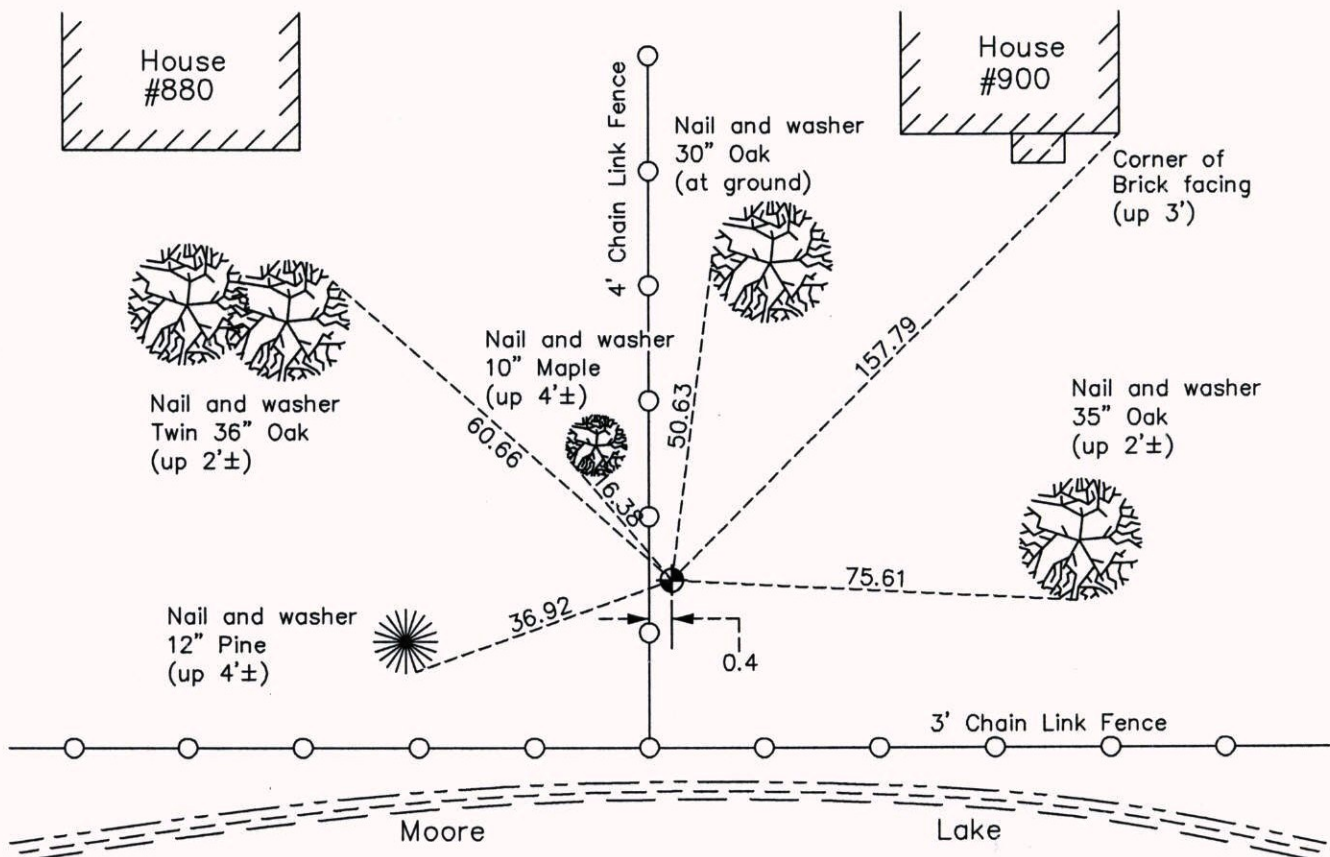

Revision Date

3/26/15

N.A.D. 1983 Coordinates
(1996 Adjustment)

County Project Coordinates

Northing 116377.7050

Easting 504870.1538

Date 6/29/04

I hereby certify that this United States public
land survey monument record is correct and
complete to the best of my knowledge and belief.

Larry D. Hoium Date 3/26/15

Larry D. Hoium, Anoka County Surveyor

Minnesota License Number 18165