

# CERTIFICATE OF LOCATION OF GOVERNMENT CORNER

County of Anoka

State of Minnesota

S.  $\frac{1}{16}$ <sup>TH</sup> OF SE  $\frac{1}{4}$  Corner of Sec. 15 Township 30 Range 24


I hereby certify that on the 16 day of SEPT., 1960, I found the described corner which was evidenced by  $\frac{3}{4}$ " I.P.

and I further certify that to perpetuate the location of said corner, I did, at the exact location thereof, place a permanent marker consisting of  $\frac{3}{4}$ " I.P.

BURIED IN CONCRETE (TIES STILL IN)

which reference or witness monuments are located in the manner following:

IRON PIPE HAS BEEN COVERED BY  
CONCRETE FOR DOG PEN. TIES STILL IN.

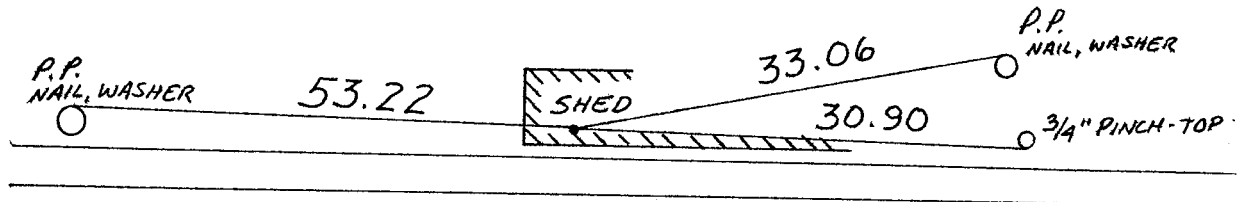

DRIVEWAY TO SCHOOL

Revised date	Revised date	Revised date
7-1-86		
8-4-89		

