

CERTIFICATE OF LOCATION OF GOVERNMENT CORNER

County of Anoka

State of Minnesota

South Line Corner of Sec. 27 Township 30 Range 24


(Minneapolis Monument #1053)

On the 18 day of November, 1965, the described corner was evidenced by a Judicial Landmark

and to perpetuate the location of said corner, at the exact location thereof, a permanent marker was placed consisting of metal cap in concrete buried in a metal casing

AND on the 13th day of January, 2023, said permanent marker was found metal cap down 1.5'± in 6" metal casing, buried 0.5'± under surface and the ties were updated

Updated reference ties are as shown below.

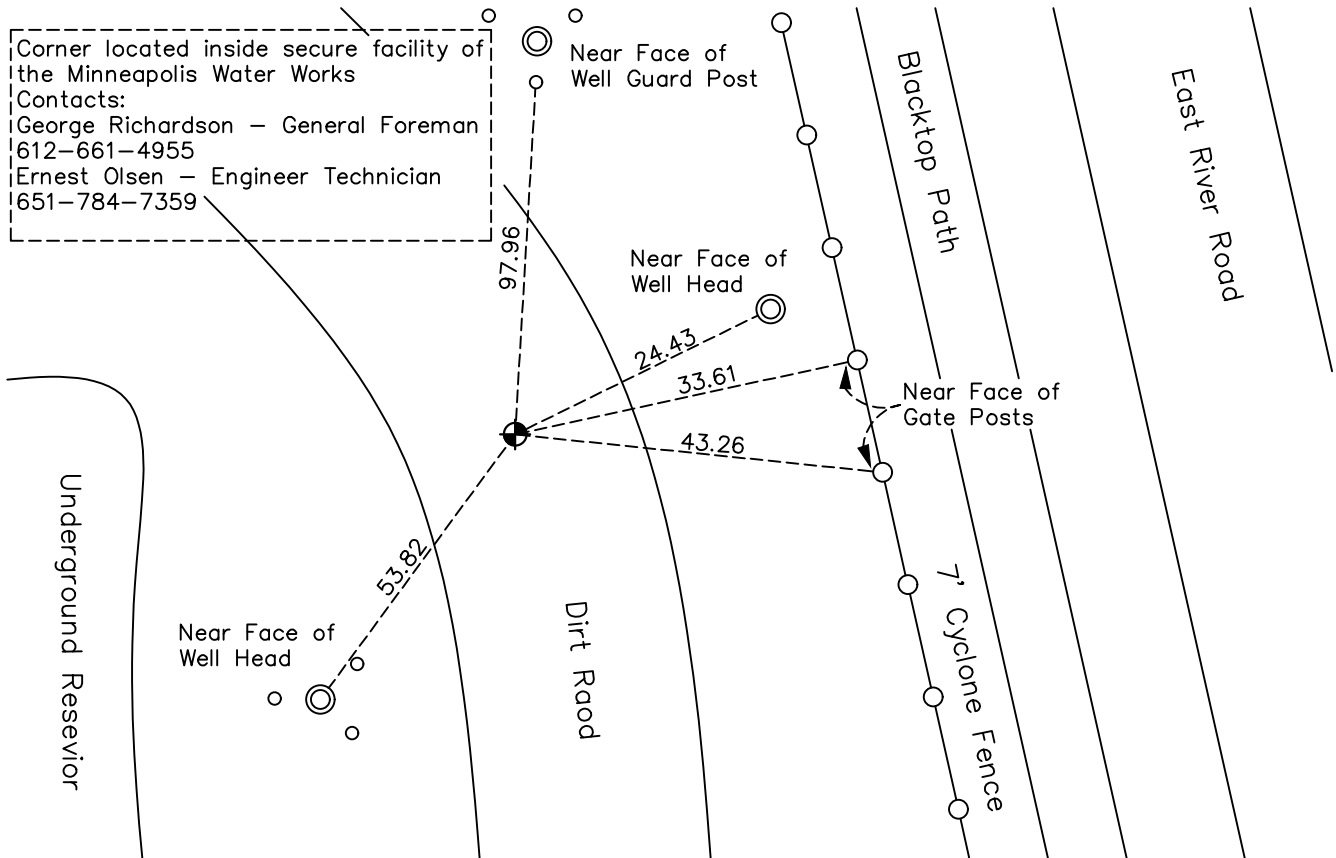

Corner located inside secure facility of the Minneapolis Water Works
 Contacts:
 George Richardson - General Foreman
 612-661-4955
 Ernest Olsen - Engineer Technician
 651-784-7359

N
 W ANOKA COUNTY SURVEYOR E
 S
 Revision Date
 01/17/2023

N.A.D. 1983 Coordinates
 (1996 Adjustment)

County Project Coordinates	
Northing	105344.0535
Easting	497409.4436
Date	6/29/2004

I hereby certify that this United States public land survey monument record is correct and complete to the best of my knowledge and belief.
David Zieglmeier Date 6/28/23
 David Zieglmeier Anoka County Surveyor
 Minnesota License Number 46179

HISTORY OF GOVERNMENT CORNER

Page No. 70

County of Anoka

State of Minnesota

South Line Corner of Sec. 27 Township 30 Range 24 (Minneapolis Monument #1053)

CORNER HISTORY:

November 30, 1965 - Found standard city of Minneapolis concrete monument buried in casing with metal cap and the ties were updated.

June 29, 1966 - Found standard city of Minneapolis concrete monument buried in casing with metal cap and the ties were updated.

August 13, 1970 - Found standard city of Minneapolis concrete monument buried in casing with metal cap and the ties were updated.

June 27, 1974 - Found standard city of Minneapolis concrete monument with metal cap buried in casing and the ties were updated.

August 5, 1977 - Found standard city of Minneapolis concrete monument with metal cap buried in casing and the ties were updated.

July 22, 1980 - Found standard city of Minneapolis concrete monument with metal cap buried in casing and the ties were updated.

June 26, 1986 - Found standard city of Minneapolis concrete monument with metal cap buried in casing and the ties were updated.

August 1, 1994 - Found standard city of Minneapolis concrete monument with metal cap buried in casing and the ties were updated.

June 29, 2004 - Found standard city of Minneapolis concrete monument with metal cap buried in casing. Established NAD 1983 (1996 adj.) Anoka County project coordinates using static GPS methods.

January 13, 2023 - Found metal cap in concrete down 1.5'± in 6" metal casing, buried 0.5'± under the surface, verified position by RTK GPS and the ties were updated.