

CERTIFICATE OF LOCATION OF GOVERNMENT CORNER

County of Anoka

State of Minnesota



East 1/4 Corner of Sec. 1 Township 32 Range 23

On the 14th day of July, 1966, the described corner was evidenced by area resurvey

and to perpetuate the location of said corner, at the exact location thereof, a permanent marker was placed consisting of a cast iron monument

AND on the 10th day of March, 2021, said permanent marker was found flush with the surface and the ties were updated

Updated reference ties are as shown below.

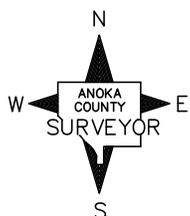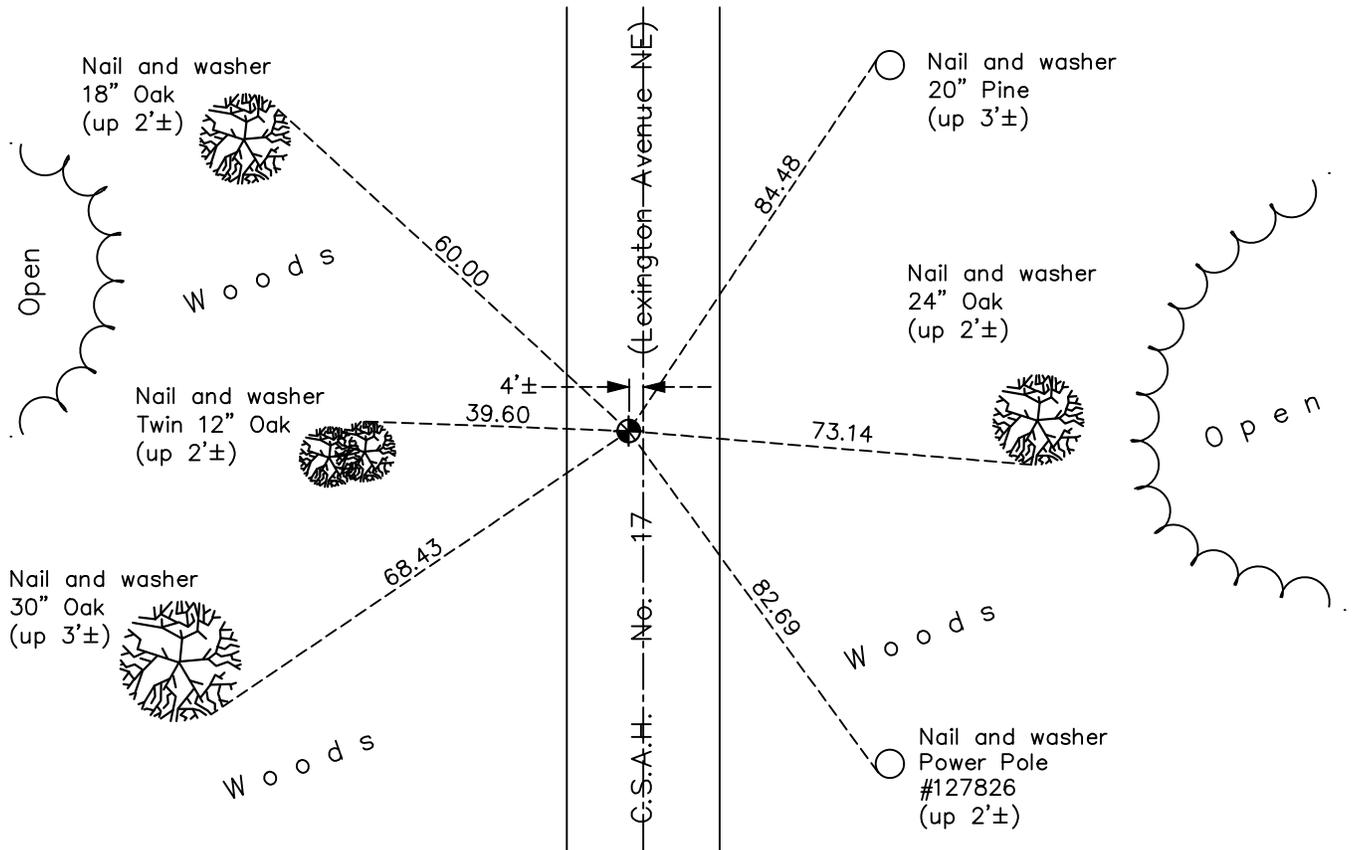

Revision Date
7/02/2021

N.A.D. 1983 Coordinates
(1996 Adjustment)

County Project Coordinates	
Northing	<u>193038.2514</u>
Easting	<u>532000.1681</u>
Date	<u>8/18/97</u>

I hereby certify that this United States public land survey monument record is correct and complete to the best of my knowledge and belief.

David Zieglmeier Date 5/31/22

David M. Zieglmeier Anoka County Deputy Surveyor
 Minnesota License Number 46179

HISTORY OF GOVERNMENT CORNER

Page No. 21

County of Anoka

State of Minnesota

East 1/4 Corner of Sec. 1 Township 32 Range 23

CORNER HISTORY:

August 1847 - This corner was established by James M. Marsh, Deputy Surveyor. Marsh marked the position by "Set post at quarter section corner" with one bearing tree marked as an accessory.

July 14, 1966 - Set cast iron monument using area resurvey. Established ties to monument.

May 25, 1971 - Found cast iron monument and updated ties.

June 4, 1975 - Found cast iron monument and updated ties.

June 5, 1978 - Found cast iron monument and updated ties.

June 23, 1981 - Found cast iron monument and updated ties.

June 26, 1984 - Found cast iron monument and updated ties.

November 15, 1991 - Found cast iron monument and updated ties.

August 23, 1996 - Found cast iron monument and updated ties.

August 18, 1997 - Found cast iron monument and updated ties. Established NAD 1983 (1996 adj.) Anoka County project coordinates by static GPS methods.

April 12, 2011 - Found cast iron monument and updated ties.

June 11, 2014 - Found cast iron monument and updated tie. Monument broke when top was being removed for future road construction. Needs Reset.

June 12, 2014 - Found broken cast iron monument and set construction ties. Removed monument.

October 7, 2014 - Set cast iron monument after road construction using static GPS methods. Verified position by VRS GPS methods. Updated ties.

February 10, 2017 - Found cast iron monument flush. Verified position by VRS GPS methods. Updated ties.

March 10, 2021 - Found cast iron monument flush. Verified position by VRS GPS methods. Updated ties.