

CERTIFICATE OF LOCATION OF GOVERNMENT CORNER

County of Anoka

State of Minnesota



Southeast Corner of Sec. 3 Township 32 Range 23

On the 3rd day of January, 1961, the described corner was evidenced by a concrete monument

and to perpetuate the location of said corner, at the exact location thereof, a permanent marker was placed consisting of a cast iron monument with a sign and post on the north side

AND on the 17th day of February, 2021, said permanent marker was found down 0.2'± and the ties were updated

Updated reference ties are as shown below.

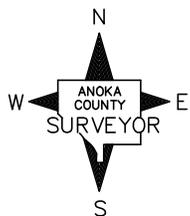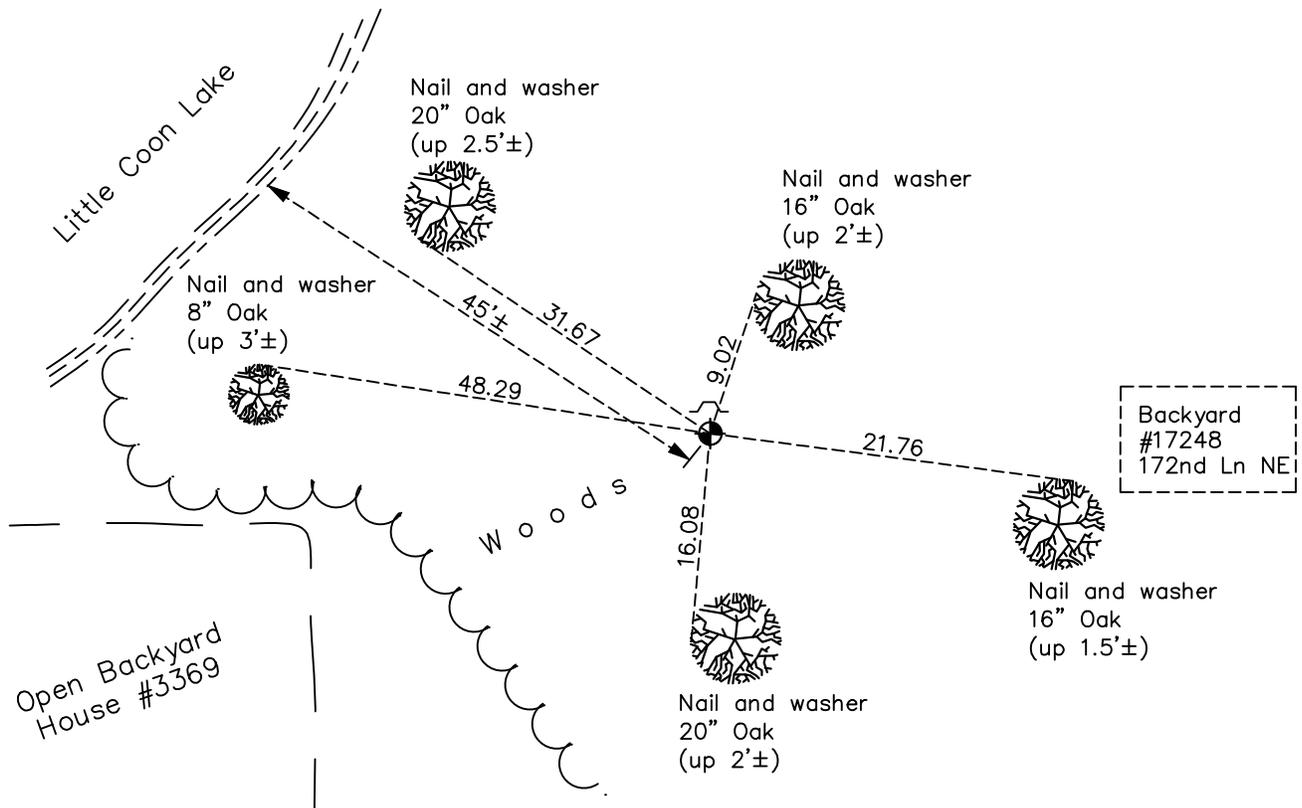

Revision Date
7/6/2021

N.A.D. 1983 Coordinates
 (1996 Adjustment)

| County Project Coordinates | |
|----------------------------|--------------------|
| Northing | <u>190535.2657</u> |
| Easting | <u>521402.2652</u> |
| Date | <u>1/03/02</u> |

I hereby certify that this United States public land survey monument record is correct and complete to the best of my knowledge and belief.

David Zieglmeier Date 5/31/22

David Zieglmeier Anoka County Surveyor
 Minnesota License Number 46179

HISTORY OF GOVERNMENT CORNER

Page No. 26

County of Anoka

State of Minnesota

Southeast Corner of Sec. 3 Township 32 Range 23

CORNER HISTORY:

February 1855 - This corner was established by Hiram Taylor, Deputy Surveyor. Taylor marked the position by "Set post corner to sections 2, 3, 10 & 11" with no bearing trees.

May 29, 1960 - Robert M. Knudsen found a concrete monument and updated the ties.

January 3, 1961 - Found concrete monument up 0.8'± with a 1" iron on north face of monument. Updated ties.

July 8, 1964 - Found concrete monument and updated ties.

July 22, 1966 - Found concrete monument and updated ties.

May 24, 1971 - Found concrete monument and updated ties.

July 17, 1974 - Found concrete monument broken off flush with ground. Replaced with a cast iron monument. Set sign and post 1'± north. Updated ties to cast iron monument.

June 19, 1975 - Found cast iron monument and updated ties.

June 8, 1978 - Found cast iron monument and updated ties.

June 25, 1981 - Found cast iron monument and updated ties.

June 29, 1984 - Found cast iron monument and updated ties.

November 7, 1990 - Found cast iron monument and updated ties.

November 15, 1991 - Found cast iron monument and updated ties.

August 28, 1996 - Found cast iron monument and updated ties.

January 3, 2002 - Found cast iron monument and updated ties. Established NAD 1983 (1996 adj.) Anoka County project coordinates by static GPS methods.

March 23, 2011 - Found cast iron monument down 0.2'± and updated ties.

February 7, 2017 - Found cast iron monument down 0.2'± and updated ties.

February 17, 2021 - Found cast iron monument down 0.2'± and updated ties.