

# CERTIFICATE OF LOCATION OF GOVERNMENT CORNER

County of Anoka

State of Minnesota


## West 1/4 Corner of Sec. 8 Township 32 Range 23

On the 16th day of October, 1961, the described corner was evidenced by a 1/2" iron pipe

and to perpetuate the location of said corner, at the exact location thereof, a permanent marker was placed consisting of a cast iron monument

AND on the 17th day of March, 2021, said permanent marker was found down 0.1'± and the ties were updated. A sign and post was found on the south side.

Updated reference ties are as shown below.

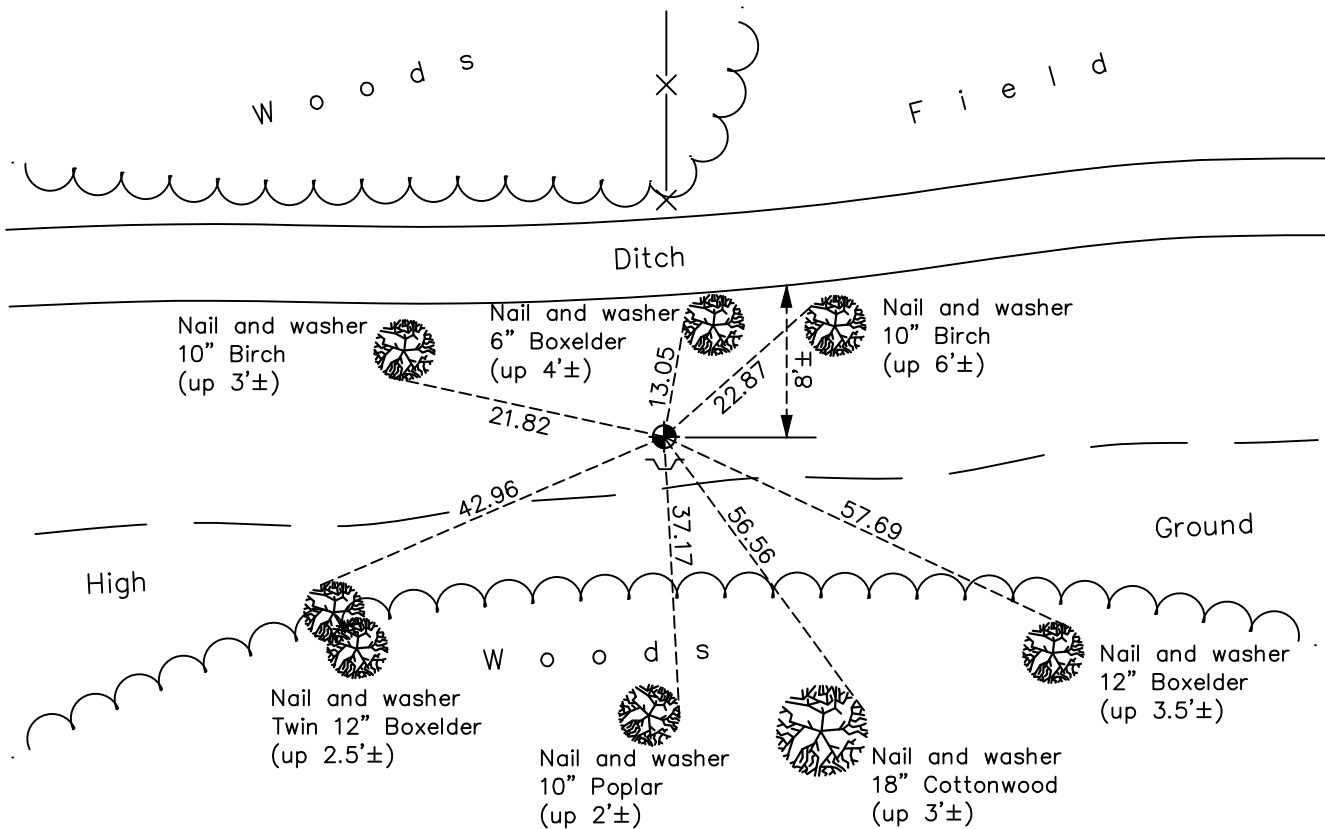

Revision Date  
7/09/2021

N.A.D. 1983 Coordinates  
(1996 Adjustment)

County Project Coordinates	
Northing	<u>188124.4951</u>
Easting	<u>505474.2237</u>
Date	<u>2/11/02</u>

I hereby certify that this United States public land survey monument record is correct and complete to the best of my knowledge and belief.

*David Zieglmeier* Date 5/31/22

David Zieglmeier Anoka County Surveyor  
Minnesota License Number 46179

# HISTORY OF GOVERNMENT CORNER

Page No. 34

County of Anoka

State of Minnesota

West 1/4 Corner of Sec. 8 Township 32 Range 23

## **CORNER HISTORY:**

February 1855 - This corner was established by Hiram Taylor, Deputy Surveyor. Taylor marked the position by "Set quarter section post" with one bearing tree marked as an accessory.

October 16, 1961 - Found 1/2" iron set by N.C. Hoium. Updated ties.

July 20, 1964 - Found 1/2" iron up 0.3'± and updated ties.

July 21, 1966 - Found 1/2" iron and updated ties.

June 14, 1971 - Set cast iron monument flush using corner ties. Updated ties.

June 18, 1975 - Found cast iron monument and updated ties.

June 22, 1978 - Found cast iron monument and updated ties.

July 13, 1981 - Found cast iron monument and updated ties.

October 19, 1987 - Reset cast iron monument after ditch construction. Updated ties.

August 29, 1996 - Found cast iron monument and updated ties.

February 11, 2002 - Found cast iron monument and updated ties. Established NAD 1983 (1996 adj.) Anoka County project coordinates by static GPS methods.

April 29, 2011 - Found cast iron monument with sign and post on the south side. Updated ties.

March 22, 2017 - Found cast iron monument down 0.1'± and updated ties.

March 17, 2021 - Found cast iron monument down 0.1'± and updated ties.